4626 79 6028

IREDELL COUNTY HEALTH DEPARTMENT

STATESVILLE 704-878-5305 MOORESVILLE 704-664-5281

IMPROVEMENT PERMIT / CERTIFICATE OF COMPLETION / OPERATION PERMIT / EXISTING SYSTEM INSPECTION

PROPERTY DESCRIPTION NO. 69998 DATE 11-6-97 TAX MAP NO. 4626874594PT Watershed: ☒ Yes ☐ No

OWNER OR CONTRACTOR Frank Mangum PHONE: Business _____ Home (704) 664-6631

ADDRESS 108 Landon Rd. Mooresville NC 28115

LOCATION Brawley School Rd. TR Beech Tree TR Kings Cross on left intersection of Hilleth

SUBDIVISION _____ BLOCK / SECTION _____ LOT _____ LOT AREA 8.4 Acres SITE CLASS. PS DESIGN FLOW 360gpd L.T.A.R. .3

Septic Tank: 1000 Gallons; STB 1012 Date 11/11/98
Pump Tank: _____ Gallons; PT _____ Date _____
Pump Make: _____ Model _____ Serial No. _____
Nitrification Field: No Fields 1 Square Feet 1200' Linear Feet 400'
No Lines 4 Trench Width 36" Max Trench Bottom Depth 24" Gravel Depth 12"

☒ New System ☐ Repair System Type: I, II, III, IV, V, VI
System Description: Grav. Conventional
Repair System Description: Same
Maintenance Agreement Required: ☐ Yes ☒ No


☒ House/Mod. Home No. Bedrooms 3
☐ Mobile Home No. Bathrooms 2
☐ Business No. Employees ____
☐ Other _____
☐ Slab ☒ Crawl Space ☐ Basement w/plumbing ☐ Basement wo/plumbing

Water Supply: ☒ Individual ☐ Community ☐ Public

Comments: Keep well 100' from Septic System
Septic System must be 10' From Property lines

Comments: TANK SWITCHED TO OTHER SIDE.

INITIAL SITE SKETCH Scale 1:50

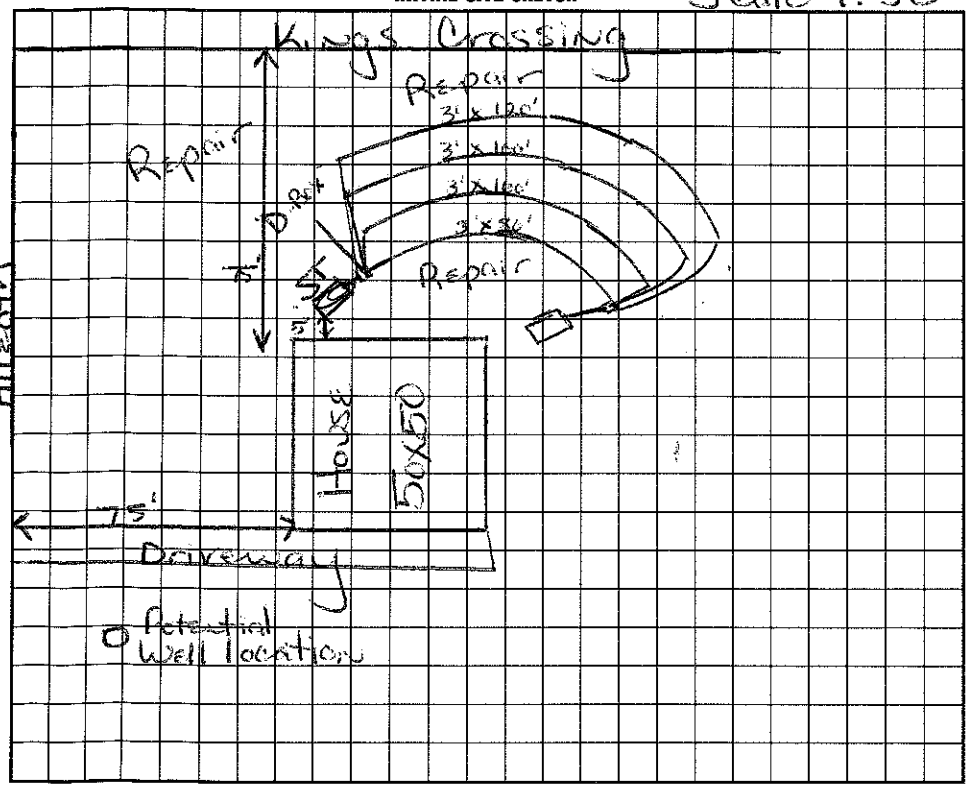

AS BUILT SKETCH

I understand that this permit can be suspended or revoked if any false information is supplied toward securing the permit/any unauthorized changes are made to the site/any unauthorized changes are made in the installation of the system. Improvement Permit is valid for 60 months from date of issuance.

Signed: Frank Mangum

Improvement Permit by: Marina H. Watson date 11/6/97

~~Existing System~~ Inspection by: Marina H. Watson date 11/6/97

Installed by: ABERNATHY

Certificate of Completion by: _____ date _____

Operation Permit by: C. [illegible] RS date 2/11/99

Construction Auth

HEALTH DEPT. COPY: WHITE INSPECTION COPY (FINAL): GREEN OWNER COPY (FINAL): YELLOW INSPECTION COPY (INITIAL): PINK OWNER COPY (INITIAL): GOLD