IREDELL COUNTY HEALTH DEPARTMENT

STATESVILLE 704-878-5305 MOORESVILLE 704-664-5281

SC

IMPROVEMENT PERMIT / AUTHORIZATION TO CONSTRUCT / OPERATION PERMIT / EXISTING SYSTEM INSPECTION

PERMIT# 152781 PIN# 4626799152 Louis Lipinsky DATE 10/21/08

OWNER OR APPLICANT Louis & Son Construction/Chester Reeves PHONE: Business 564-0934 Home 704 658 9828

ADDRESS 120 Clarendon Pl Aiken SC 29801

LOCATION Brawley School Rd TR Blume Tr Beech Tree TR Kings Cross TR Boone Ln on right #108

SUBDIVISION Lot BLOCK / SECTION 8 LOT 1563 LOT AREA 1.14 Acre SITE CLASS PS DESIGN FLOW 360gpd L.T.A.R.

Existing

Septic Tank: 1250 Gallons: STB Date

Pump Tank: 1250 Gallons: PT Date

Pump Make: Model Serial No.

Nitrification Field: No Fields 1 Square Feet Linear Feet 200'

No Lines 5 @ 40' Trench Width Existing Maximum Bottom Depth Gravel Depth ☐ Gravity ☒ Pressure

☐ New System ☐ Repair ☐ Expansion System Type: I II III IV V VI

System Description: Existing Pump-LP-Panel Blk

Repair System Description: Same

Maintenance Agreement Required: ☐ Yes ☐ No

☒ House/Mod. Home No. Bedrooms 3

☐ Mobile Home No. Persons

☐ Business No. Employees

☐ Other

Water Supply: ☒ Individual ☐ Public ☐ Community


☐ Slab ☒ Crawl Space ☐ Basement w/plumbing ☒ Basement wo/plumbing

partial

Comments:/Conditions: Existing Septic System appears to be functioning okay at time of inspection.

Comments:/Conditions: Number of Bedrooms to remain as 3. Addition will not effect Septic System. Septic System installed 10/1988.

INITIAL SITE SKETCH

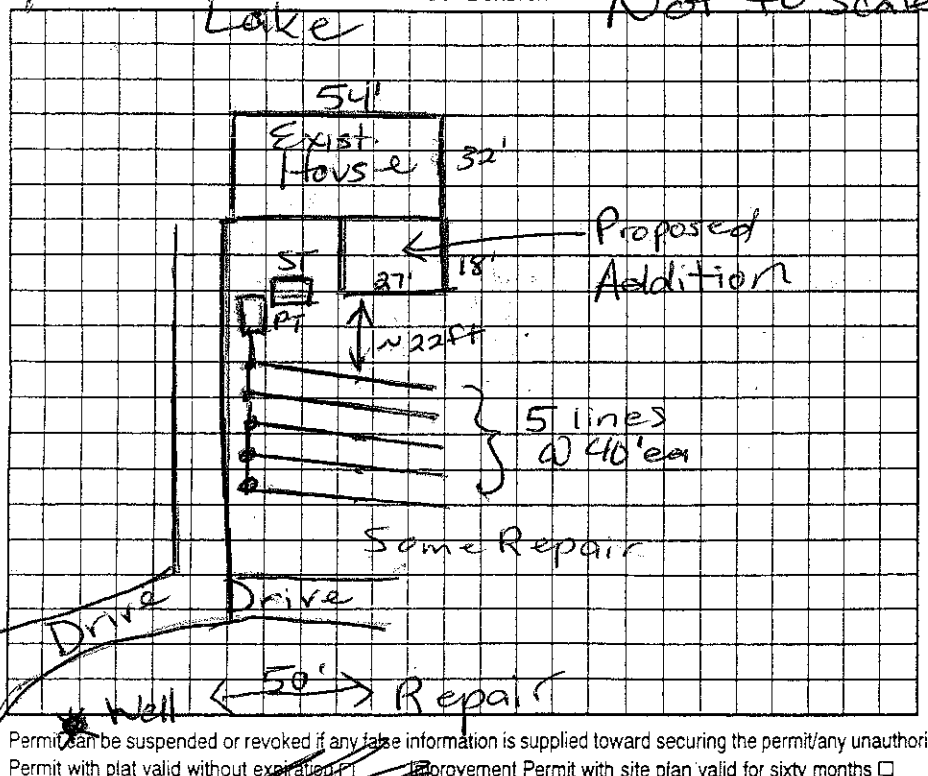

AS BUILT SKETCH

Permit can be suspended or revoked if any false information is supplied toward securing the permit/any unauthorized changes are made to the site/any unauthorized changes are made in the installation of the system. Improvement Permit with plat valid without expiration ☐ Improvement Permit with site plan valid for sixty months ☐ Authorization to Construct is valid for a period equal to that of Improvement Permit – not to exceed sixty months.

Signed: RS date 10-21-08 Installed by:

Improvement Permit by: RS date 10/21/08 Operation Permit by: date

Authorization to Construct by: RS date 10/21/08 Existing System Inspection by: RS date 10/21/08

HEALTH DEPT. COPY: WHITE OWNER COPY (FINAL): YELLOW OWNER COPY (INITIAL): PINK