IREDELL COUNTY HEALTH DEPARTMENT

STATESVILLE 704-878-5305 — MOORESVILLE 704-664-5281

IMPROVEMENT PERMIT / AUTHORIZATION TO CONSTRUCT / OPERATION PERMIT / EXISTING SYSTEM INSPECTION

114668

50.00 Paid Cash

PERMIT# 078672 PIN# 4625941684 (pt) 4626803728 DATE July 24, 03

OWNER OR CONTRACTOR CRI // Hughes & Assoc. PHONE: Business Home

ADDRESS 6425-A Bannington Dr., Charlotte N.C. 28027

LOCATION Brawley Schl. Rd. TL Great Pt. Dr. TL Wild Harbor Rd. TL Coral Bells Ct. #107

SUBDIVISION The Point BLOCK / SECTION III LOT 364 LOT AREA 38729-ft² SITE CLASS PS DESIGN FLOW 600 gpd L.T.A.R. .25-.3

Septic Tank: 1500 Gallons; STB 338 Date 12-12-03

Pump Tank: 1500 Gallons; PT 431 Date 5-25-03

Pump Make: Myers Model ME50 Serial No.

Nitrification Field: No Fields 1 Square Feet 1800 Linear Feet 600

No Lines 5@120' Trench Width 36" Max Trench Bottom Depth 36" Gravel Depth NA

☑ New System ☐ Repair System Type: I, II, III, IV, V, VI

System Description: 9m - 25% Reduction

Repair System Description: LPPBPS

Maintenance Agreement Required: ☐ Yes ☑ No initially

☑ House/Mod. Home ☐ Mobile Home ☐ Business ☐ Other

No. Bedrooms 5 No. Bathrooms 4 No. Employees


☐ Slab ☑ Crawl Space ☐ Basement w/plumbing ☐ Basement wo/plumbing

Water Supply: ☐ Individual ☑ Public ☑ Community


Comments:/Conditions:

Comments:/Conditions: Installed EZ Flow for Drainfield Pressure, elect & alarm 2/23/04 mp

INITIAL SITE SKETCH

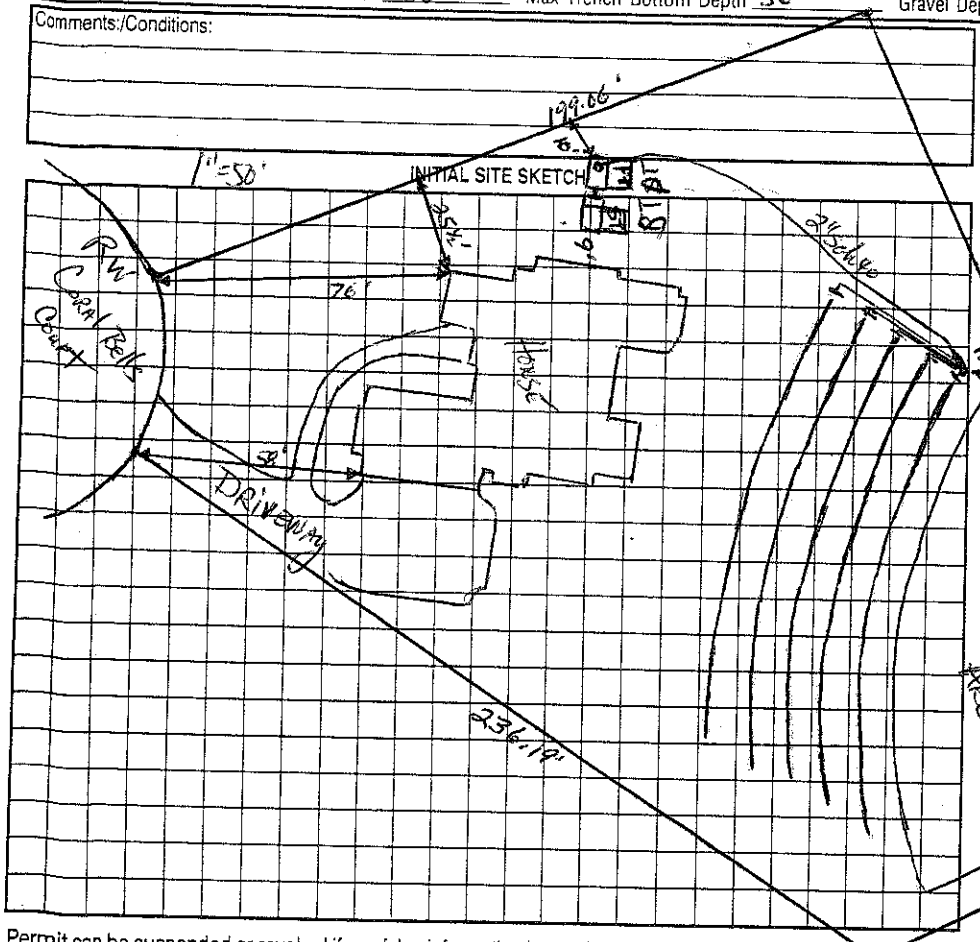

AS BUILT SKETCH

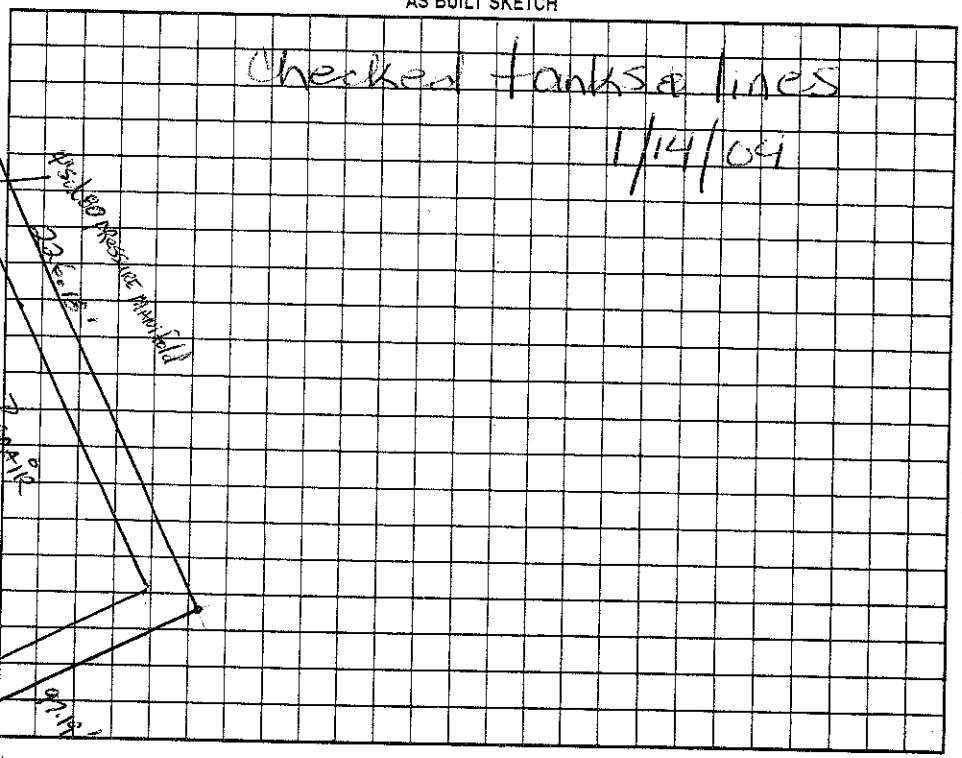

Permit can be suspended or revoked if any false information is supplied toward securing the permit/any unauthorized changes are made to the site/any unauthorized changes are made in the installation of the system. Improvement Permit with plat valid without expiration. Improvement Permit with site plan valid for sixty months. Authorization to Construct is valid for a period equal to that of Improvement Permit – not to exceed sixty months.

Signed: Bill Poplin date 7-22-03

Improvement Permit by: RS date 7-21-03

Authorization to Construct by: RS date 7-21-03

Installed by: R & H RS

Operation Permit by: Mark Hilderbran date 2/23/04

Existing System Inspection by: date

HEALTH DEPT. COPY: WHITE OWNER COPY (FINAL): YELLOW OWNER COPY (INITIAL): PINK