1R5 Start 11:00

IREDELL COUNTY HEALTH DEPARTMENT

STATESVILLE 704-878-5305 MOORESVILLE 704-664-5281

IMPROVEMENT PERMIT / AUTHORIZATION TO CONSTRUCT / OPERATION PERMIT / EXISTING SYSTEM INSPECTION

PERMIT# 018351 PIN# ~~4625941684 (of)~~ (HUGHES + ASSOCIATES) 4626804213 DATE April 28, '99

OWNER OR CONTRACTOR Crescent Resources Inc // The Point on Norman PHONE: Business ______ Home ______

ADDRESS 2214 Brawley Sch Rd. Mooresville

LOCATION Brawley Sch Rd. TL Great Point Dr. on Right

SUBDIVISION The Point BLOCK / SECTION III LOT 272 LOT AREA 43,529 ft² SITE CLASS. RS DESIGN FLOW 480gpd L.T.A.R. ~.25

Septic Tank: 1500 ~~1000~~ Gallons; STB 338 Date 7-7-01
Pump Tank: 1000 Gallons; PT 27 Date 7-6-01
Pump Make: Myers Model ME 3 F Serial No. ______
Nitrification Field: No Fields 1 Square Feet 1440 Linear Feet 480
No Lines 4@120' Trench Width 36" Max Trench Bottom Depth 36" Gravel Depth NA

☒ New System ☐ Repair System Type: I, II, (III), IV, V, VI
System Description: pin - Innovative / 25% Reduction
Repair System Description: LP Panel Block
Maintenance Agreement Required: ☐ Yes ☒ No

☒ House/Mod. Home No. Bedrooms 4
☐ Mobile Home No. Bathrooms 4
☐ Business No. Employees ______
☐ Other ______

☐ Slab ☒ Crawl Space ☐ Basement w/plumbing ☐ Basement wo/plumbing


Water Supply:
☐ Individual
☒ Public
☒ ~~Community~~

Comments:/Conditions: * ONE INSpection port per Lateral

Comments:/Conditions: EZ Flow lines installed as drawn inspected 7/18/2001

INITIAL SITE SKETCH

1" = 50'

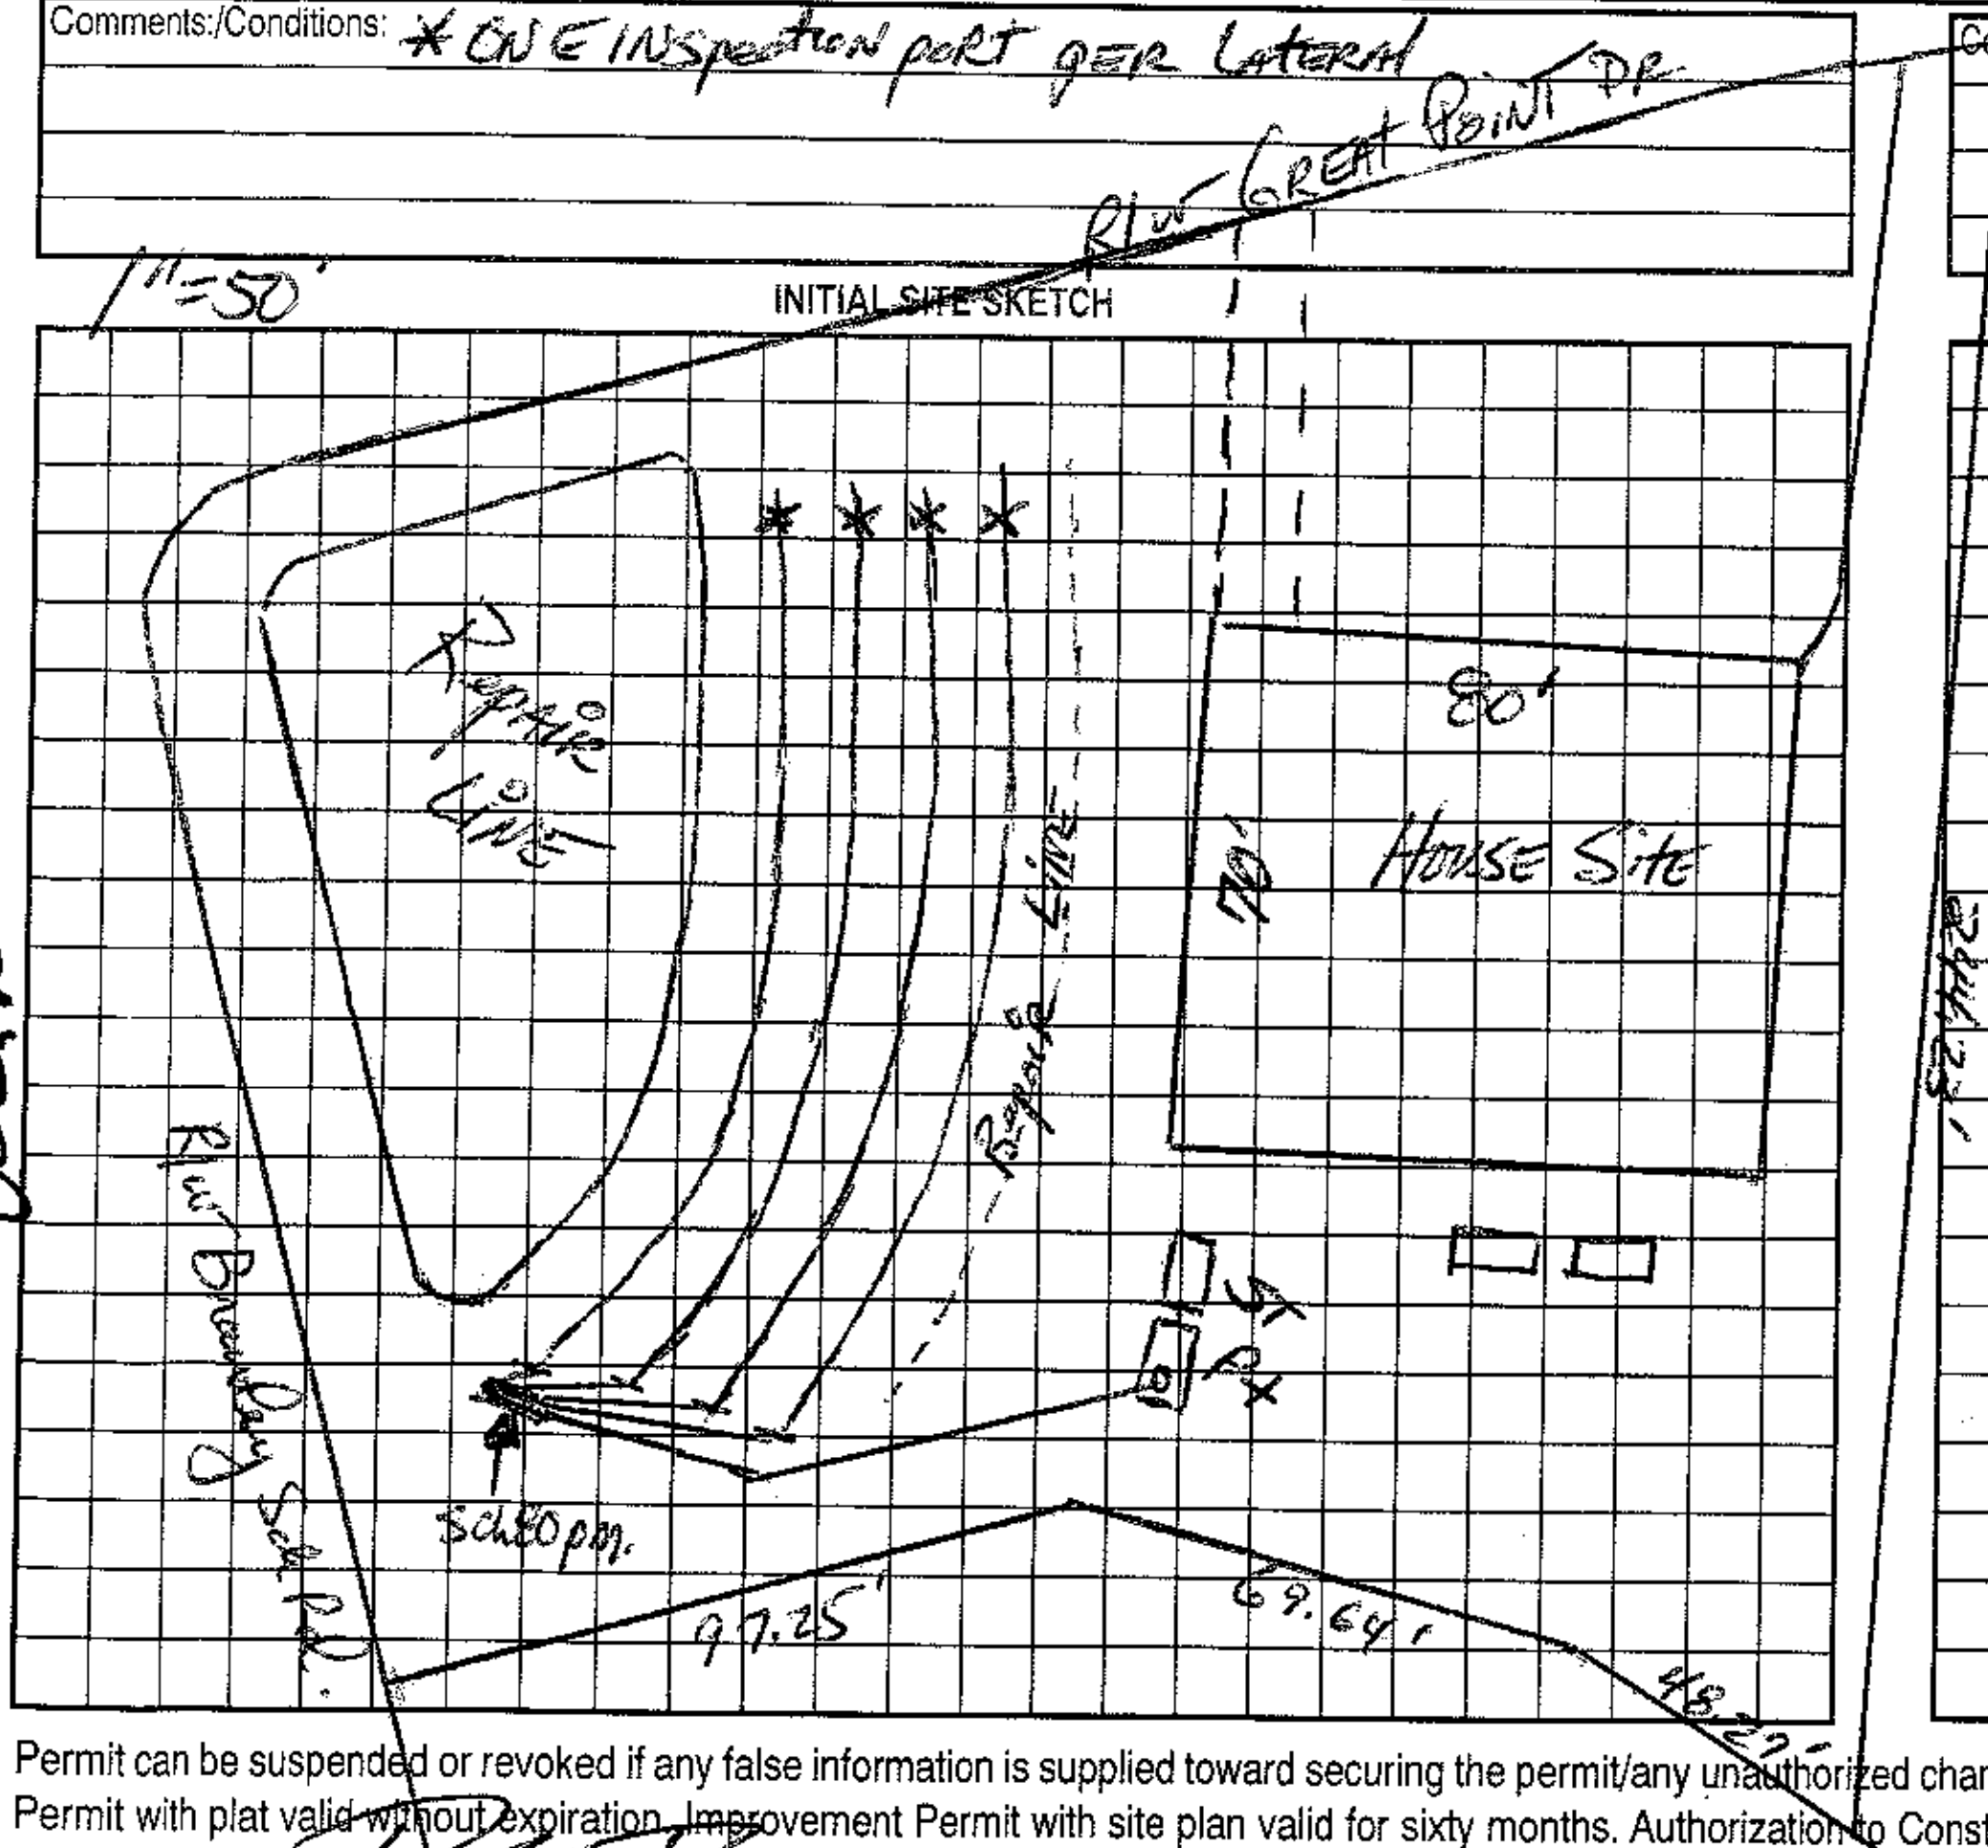

AS BUILT SKETCH

Permit can be suspended or revoked if any false information is supplied toward securing the permit/any unauthorized changes are made to the site/any unauthorized changes are made in the installation of the system. Improvement Permit with plat valid without expiration. Improvement Permit with site plan valid for sixty months. Authorization to Construct is valid for a period equal to that of Improvement Permit – not to exceed sixty months.

Signed: [signature] date 5-14-99
Improvement Permit by: [signature] RS date 4-28-99
Authorization to Construct by: Wesley Sparks R.S. date 4/18/01

Installed by: R&H
Operation Permit by: Maria H. H. Dotson R.S. date 10/25/2001
Existing System Inspection by: ______ date ______

HEALTH DEPT. COPY: WHITE OWNER COPY (FINAL): YELLOW OWNER COPY (INITIAL): PINK