125

# IREDELL COUNTY HEALTH DEPARTMENT

STATESVILLE 704-878-5305 MOORESVILLE 704-664-5281

## IMPROVEMENT PERMIT / AUTHORIZATION TO CONSTRUCT / OPERATION PERMIT / EXISTING SYSTEM INSPECTION

PERMIT# 078725 PIN# 4625941684 (pt) John R Poole Bld. 4626 80 4408 DATE May 10, '99

OWNER OR CONTRACTOR Crescent Resources clo // The Point on Norman // PHONE: Business 660-1185 Home

ADDRESS 2214 Brawley Sch Rd. Mooresville

LOCATION Brawley Sch Rd. TL Great Point Drive immediately on left

SUBDIVISION The Point BLOCK / SECTION III LOT 376 LOT AREA 47,002 A/L + STE 370A SITE CLASS. RS DESIGN FLOW 480gpd L.T.A.R. ~0.25

Septic Tank: 1500+ Gallons; STB 339 Date 7/23/01 ☑ New System ☐ Repair System Type: I, II, III, IV, V, VI

Pump Tank: 1000 Gallons; PT 27 Date 4/17/01 System Description: PM - Innovative 25% Reduction

Pump Make: Delta Model WEO 51-HH Serial No. 2/26/01 Repair System Description: Same

Nitrification Field: No. Fields 1 Square Feet 1800 Linear Feet 600 Maintenance Agreement Required: ☐ Yes ☑ No

No Lines 6@100' Trench Width 36" Trench Bottom Depth 48" Gravel Depth NA

☑ House/Mod. Home No. Bedrooms 4
☐ Mobile Home No. Bathrooms 4
☐ Business No. Employees
☐ Other

☐ Slab ☑ Crawl Space ☐ Basement w/plumbing ☐ Basement wo/plumbing

Water Supply: ☐ Individual ☑ Public ☑ Community

Comments:/Conditions:

Install LATERALS @ 48" trench bottom depth.


* ONE inspection port PER LATERAL.

2-17-01 Reviewed house & site plan; appears in compliance w/ TP Staff

Comments:/Conditions:

INITIAL SITE SKETCH

1" = 100'

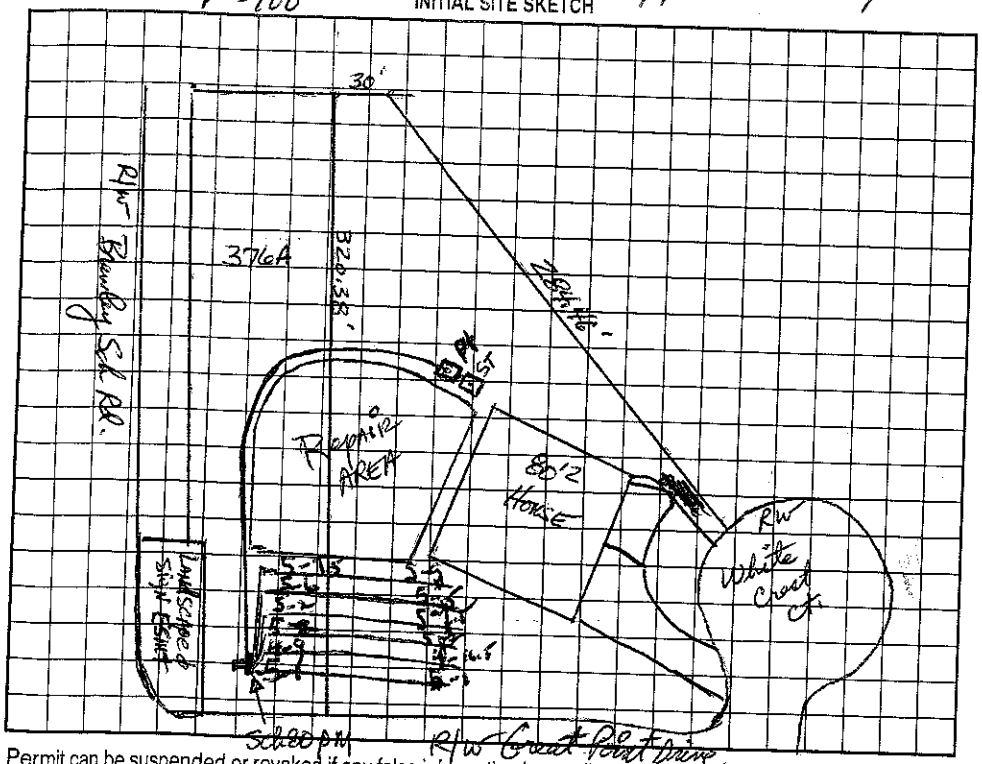


AS BUILT SKETCH

Permit can be suspended or revoked if any false information is supplied toward securing the permit/any unauthorized changes are made to the site/any unauthorized changes are made in the installation of the system. Improvement Permit with plat valid without expiration. Improvement Permit with site plan valid for sixty months. Authorization to Construct is valid for a period equal to that of Improvement Permit – not to exceed sixty months.

Signed: [signature] date 5-14-99 Installed by: Hallman Const.

Improvement Permit by: [signature] date 5-10-99 Operation Permit by: Wesley Sparks RS. date 2/20/02

Authorization to Construct by: [signature] date 2-17-01 Existing System Inspection by: date

HEALTH DEPT. COPY: WHITE OWNER COPY (FINAL): YELLOW OWNER COPY (INITIAL): PINK