IREDELL COUNTY HEALTH DEPARTMENT

STATESVILLE 704-878-5305 50.00 Paid MOORESVILLE 704-664-5281

IMPROVEMENT PERMIT / AUTHORIZATION TO CONSTRUCT / OPERATION PERMIT / EXISTING SYSTEM INSPECTION

PERMIT# 27674 / 29126 PIN# 4625 94 1684 4626-80-5972 DATE 5/20/05

OWNER OR CONTRACTOR Simonini Bldrs PHONE: Business 704-358-9940 Home

ADDRESS 1410 South Blvd Charlotte

LOCATION BSR TL Great Point, TL Wild Harbor on Lt.

SUBDIVISION Point BLOCK / SECTION 3 LOT 366 LOT AREA 0676 Ac SITE CLASS. RS DESIGN FLOW 600 L.T.A.R. 0.25

Septic Tank: 1500 Gallons; STB 338 Date 12-7-05

Pump Tank: Gallons; PT Date

Pump Make: Model Serial No.

Nitrification Field: No Fields 1 Square Feet 1800 Linear Feet 600

No Lines 6@100' Trench Width 36" Trench Bottom Depth 48" Gravel Depth —

☒ New System ☐ Repair System Type: I, II, III, IV, V, VI

System Description: Gravity 25% Red. (Accepted)

Repair System Description: LP Panel Block

Maintenance Agreement Required: ☐ Yes ☒ No

☒ House/Mod. Home ☐ Mobile Home ☐ Business ☐ Other

No. Bedrooms 5 No. Bathrooms No. Employees

☐ Slab ☒ Crawl Space ☐ Basement w/plumbing ☐ Basement wo/plumbing

Water Supply: ☐ Individual ☐ Public ☒ Community


Comments:/Conditions: Checked ST & lines 1/27/06

1" = 40'


Comments:/Conditions: Used EZ Flow for Drainfield

Checked dist box 1/30/06

INITIAL SITE SKETCH

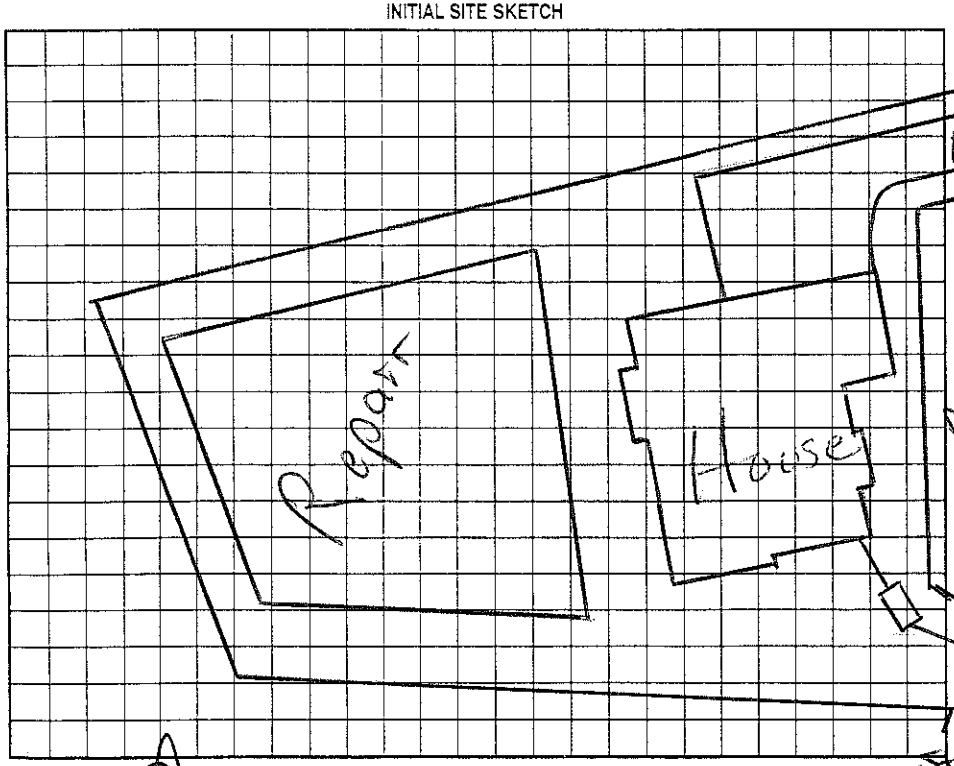

AS BUILT SKETCH

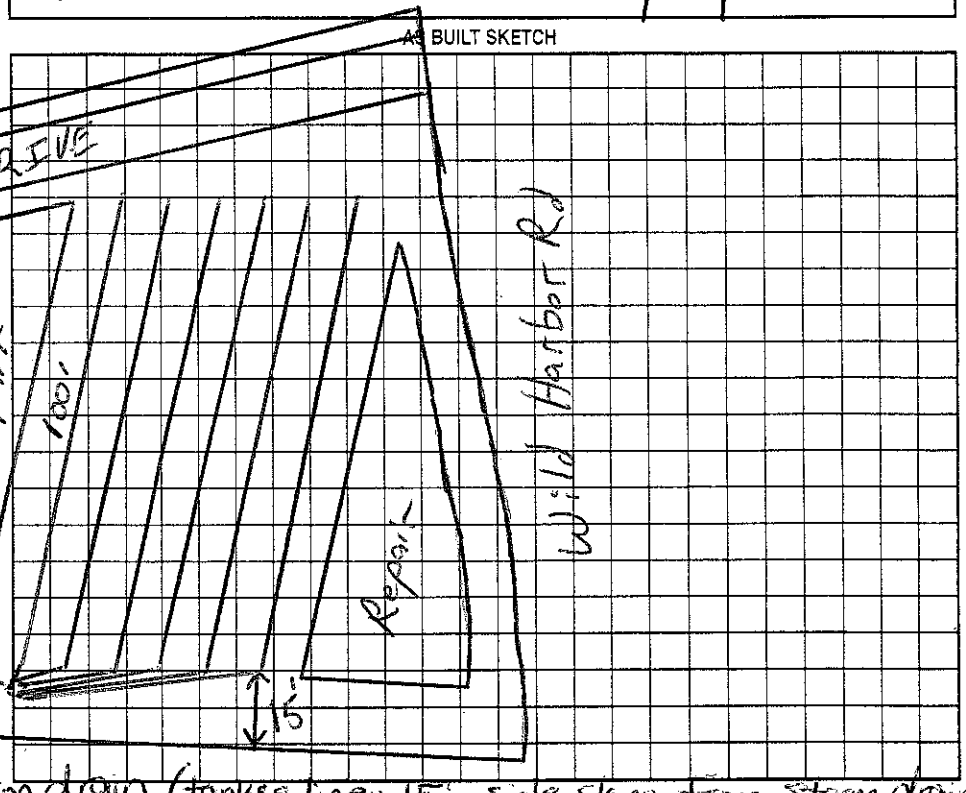

Permit can be suspended or revoked if any false information is supplied toward securing the permit/any unauthorized changes are made to the site/any unauthorized changes are made in the installation of the system. Improvement Permit with plat valid without expiration. Improvement Permit with site plan valid for sixty months. Authorization to Construct is valid for a period equal to that of Improvement Permit – not to exceed sixty months.

Signed: date 5.27.05 Installed by: R & H

Improvement Permit by: RS date 5/20/05 Operation Permit by: Maria H Dolan RS date 1/30/06

Authorization to Construct by: RS date 5/20/05 Existing System Inspection by: date

HEALTH DEPT COPY: WHITE OWNER COPY (FINAL): YELLOW OWNER COPY (INITIAL): PINK