IREDELL COUNTY HEALTH DEPARTMENT

STATESVILLE 704-878-5305 MOORESVILLE 704-664-5281

2:30

IMPROVEMENT PERMIT / AUTHORIZATION TO CONSTRUCT / OPERATION PERMIT / EXISTING SYSTEM INSPECTION

PERMIT# 78352 PIN# ~~4625441684 (PT)~~ 4626806204 DATE 7/27/00

OWNER OR CONTRACTOR CL&T / HUGHS & ASSOCIATES PHONE: Business 361-5897 Home

ADDRESS CL&T - 2214 BRAWLEY SCHOOL RD.

LOCATION BRAWLEY SCHOOL RD - TL GREAT POINT - 2nd LOT ON RT

SUBDIVISION POINT BLOCK / SECTION III LOT 273 LOT AREA 41376 ft² SITE CLASS PS DESIGN FLOW 480GPD L.T.A.R. .39 gpd/ft²

Septic Tank: 1000 + Gallons; STB 338 Date 1-23-01

Pump Tank: 1000 + Gallons; PT 27 Date 12-3-99

Pump Make: Model Serial No.

Nitrification Field: No Fields 1 Square Feet 1200 Linear Feet 400

No Lines 4@100' Trench Width 36" Max Trench Bottom Depth 36" Gravel Depth N/A

☑ New System ☐ Repair System Type: I, II, III, IV, V, VI

System Description: PUMP INNOVATIVE

Repair System Description: LP INNOVATIVE

Maintenance Agreement Required: ☐ Yes ☑ No

☑ House/Mod. Home No. Bedrooms 4

☐ Mobile Home No. Bathrooms 4

☐ Business No. Employees

☐ Other


☐ Slab ☑ Crawl Space ☑ Basement w/plumbing ☐ Basement wo/plumbing

Water Supply: ☐ Individual ☐ Public ☑ Community


Comments:/Conditions:

Comments:/Conditions: Polylok filter installed. EZ Flow lines installed Tank checked 3/7/01 MD Pressure, alarm & electrical checked 3/30/2001

INITIAL SITE SKETCH

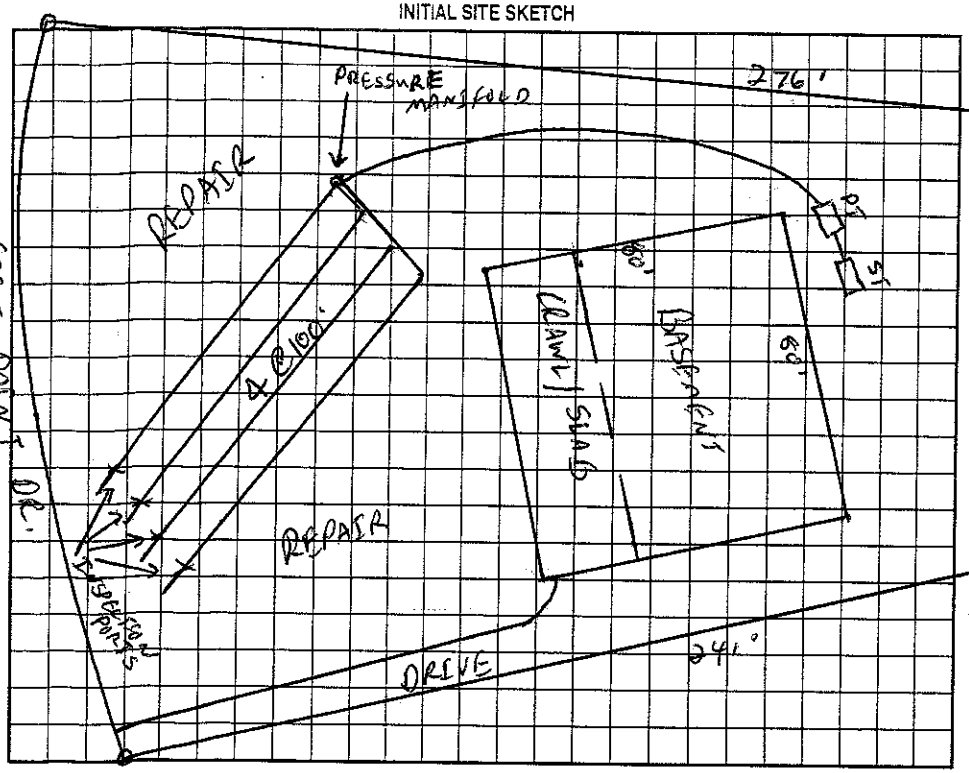

AS BUILT SKETCH

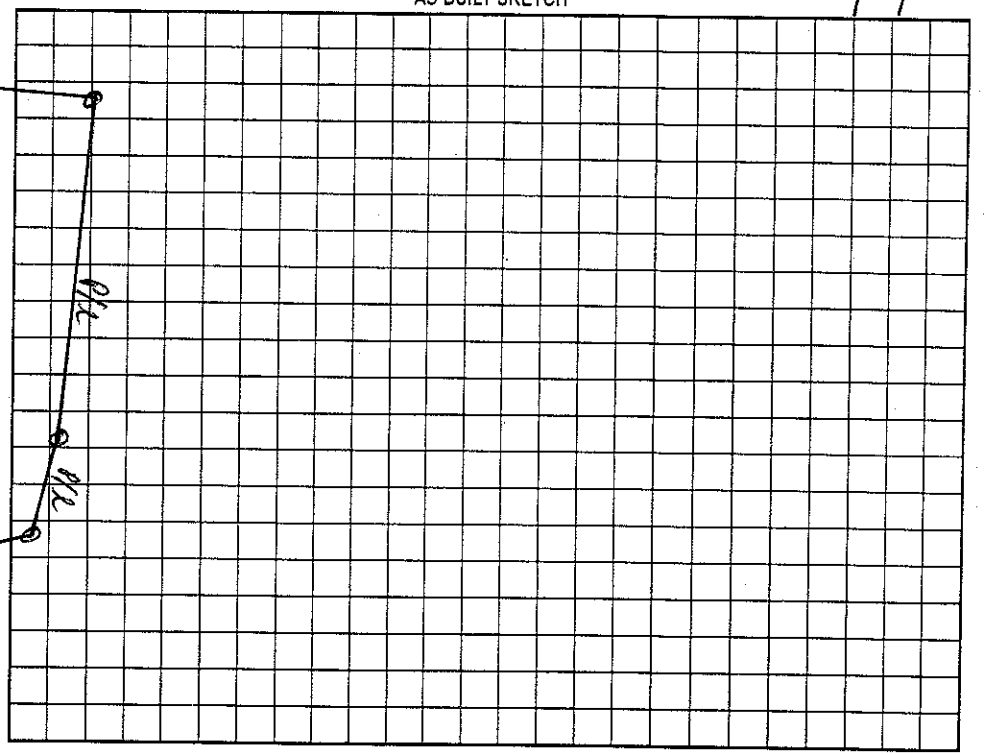

Permit can be suspended or revoked if any false information is supplied toward securing the permit/any unauthorized changes are made to the site/any unauthorized changes are made in the installation of the system. Improvement Permit with plat valid without expiration. Improvement Permit with site plan valid for sixty months. Authorization to Construct is valid for a period equal to that of Improvement Permit – not to exceed sixty months.

Signed: date

Improvement Permit by: RS date 7/27/00

Authorization to Construct by: RS date 7/27/00

Installed by: RP H INC

Operation Permit by: Maria H. H. Dotson RS date 3/30/2001

Existing System Inspection by: date

HEALTH DEPT. COPY: WHITE OWNER COPY (FINAL): YELLOW OWNER COPY (INITIAL): PINK