IREDELL COUNTY HEALTH DEPARTMENT

STATESVILLE 704-878-5305 MOORESVILLE 704-664-3281

IMPROVEMENT PERMIT / AUTHORIZATION TO CONSTRUCT / OPERATION PERMIT / EXISTING SYSTEM INSPECTION

PERMIT# 078353 PIN# 4625744684 (Lot) 4626-80-7139 DATE August 10, 99

OWNER OR CONTRACTOR Crescent Resources - The Point at Normans II Hughes & Assoc. PHONE: Business _____ Home _____

ADDRESS 2214 Brawley Sch Rd. Mooresville

LOCATION Brawley Sch Rd. TL GREAT Point DRIVE on Right

SUBDIVISION The Point BLOCK / SECTION III LOT 274 LOT AREA 35,250 ft² SITE CLASS. PS DESIGN FLOW 480 gpd L.T.A.R. .025

Septic Tank: 1000 Gallons; STB 338 Date 10/16/99
Pump Tank: 1000 Gallons; PT 29 Date 12/29/99
Pump Make: MYERS Model ME 503-21 Serial No 2532D009
Nitrification Field: No Fields 1 Square Feet 960 Linear Feet 320
No Lines 4@20' Trench Width 36" Max Trench Bottom Depth 36"

☐ New System ☐ Repair System Type: I, II, III, (V), V, VI
System Description: LP Panel Block
Repair System Description: SAME
Maintenance Agreement Required: ☑ Yes ☐ No
Gravel Depth N/A


☑ House/Mod. Home No. Bedrooms 4
☐ Mobile Home No. Bathrooms 4
☐ Business No. Employees ____
☐ Other ____
☐ Slab ☑ Crawl Space ☐ Basement w/plumbing ☐ Basement wo/plumbing

Water Supply:
☐ Individual
☑ Public
☑ Community


Comments:/Conditions: This replaces permit issued 5-3-99

Comments:/Conditions: 12/3/99 plumbing inspected drain lines
2/24/00 Pressure set, Tanks,

1"=50' INITIAL SITE SKETCH

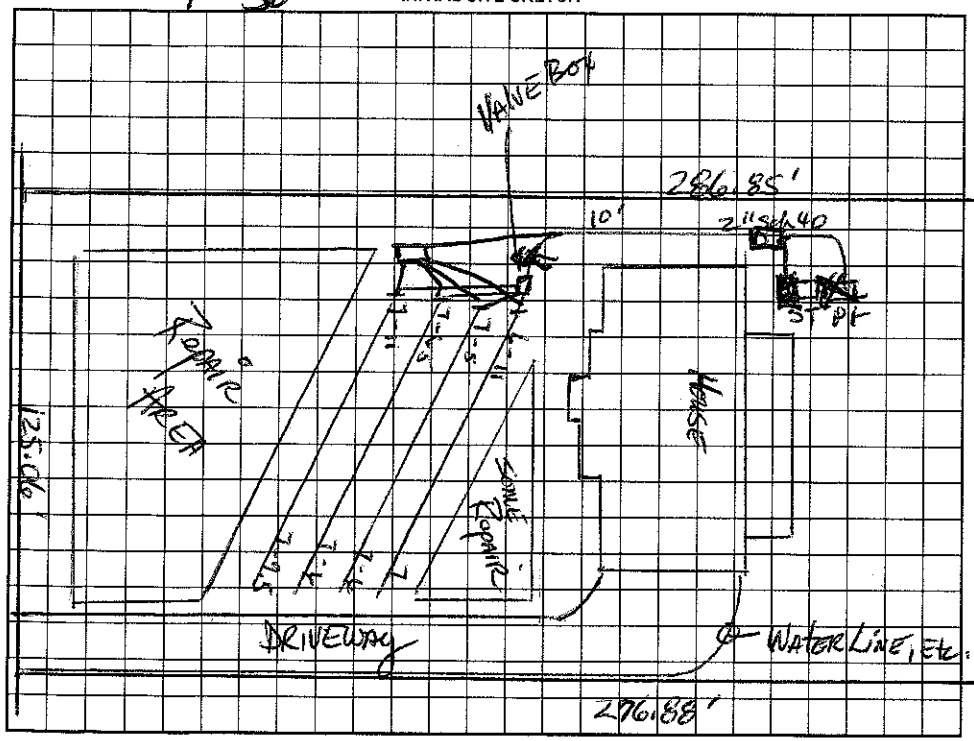

AS BUILT SKETCH

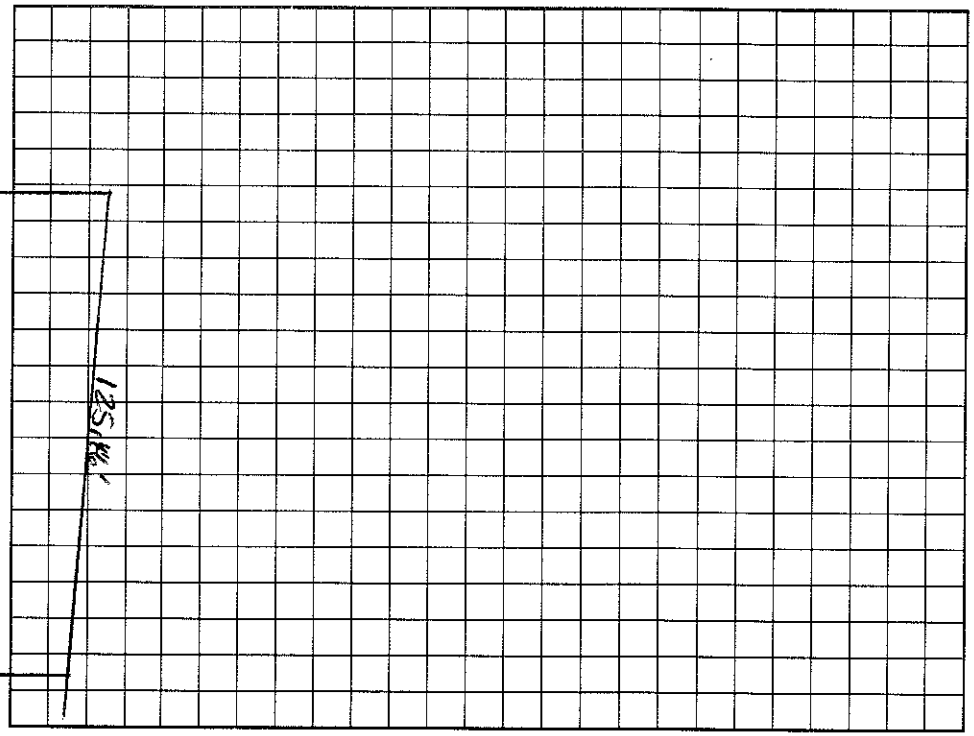

Permit can be suspended or revoked if any false information is supplied toward securing the permit/any unauthorized changes are made to the site/any unauthorized changes are made in the installation of the system. Improvement Permit with plat valid without expiration. Improvement Permit with site plan valid for sixty months. Authorization to Construct is valid for a period equal to that of Improvement Permit – not to exceed sixty months.

Signed: *William Popson - date 8-10-99
Improvement Permit by: Daniel Hussey IRS date 8-10-99
Authorization to Construct by: Daniel Hussey IRS date 8-10-99

Installed by: R + H Inc
Operation Permit by: Maria H. Dotson RS date 6/12/00
Existing System Inspection by: _____ date _____

HEALTH DEPT. COPY: WHITE OWNER COPY (FINAL): YELLOW OWNER COPY (INITIAL): PINK