Tim 201-7514 125 1:30-2

IREDELL COUNTY HEALTH DEPARTMENT

STATESVILLE 704-878-5305 MOORESVILLE 704-664-5281

IMPROVEMENT PERMIT / AUTHORIZATION TO CONSTRUCT / OPERATION PERMIT / EXISTING SYSTEM INSPECTION

PERMIT# 078722 PIN# 4625.94 4684 (pt) 4626-80-7503 DATE May 7, '99

OWNER OR CONTRACTOR Crescent Resources Inc/The Point on Norman (HUGHES & ASS.) PHONE: Business 660-1185 Home

ADDRESS 2214 Brawley School Rd Mooresville

LOCATION Brawley School Rd N Great Point Dr. on left at jct w/ White Crest Ct.

SUBDIVISION The Point BLOCK / SECTION III LOT 373 LOT AREA 34,799 SITE CLASS. P5 DESIGN FLOW 480gpd L.T.A.R. n.3

Septic Tank: ~~Concrete~~ Gallons; STB 338 Date 11-12-00

Pump Tank: 1500 Gallons; PT Date

Pump Make: Model Serial No.

Nitrification Field: ☐ No Fields Square Feet 1350 Linear Feet 450

No Lines 5@90' Trench Width 36" ~~Max~~ Trench Bottom Depth 36" Gravel Depth N/A

☑ New System ☐ Repair System Type: I, II, ~~III~~ IV, V, VI

System Description: GRAVITY INNOVATIVE -25% Red.

Repair System Description: LPP INNOVATIVE

Maintenance Agreement Required: ☐ Yes ☑ No

~~☐~~ House/Mod. Home No. Bedrooms 4

☐ Mobile Home No. Bathrooms 4

☐ Business No. Employees

☐ Other


☐ Slab ☑ Crawl Space ☐ Basement w/plumbing ☐ Basement wo/plumbing

Water Supply: ☐ Individual ~~☐~~ Public ~~☐~~ Community


Comments:/Conditions: * ONE inspection port per lateral. Polylok filter installed.

Comments:/Conditions: Installed EZ Flow/ EZ Lay in 5 lines.

INITIAL SITE SKETCH 1"=50'

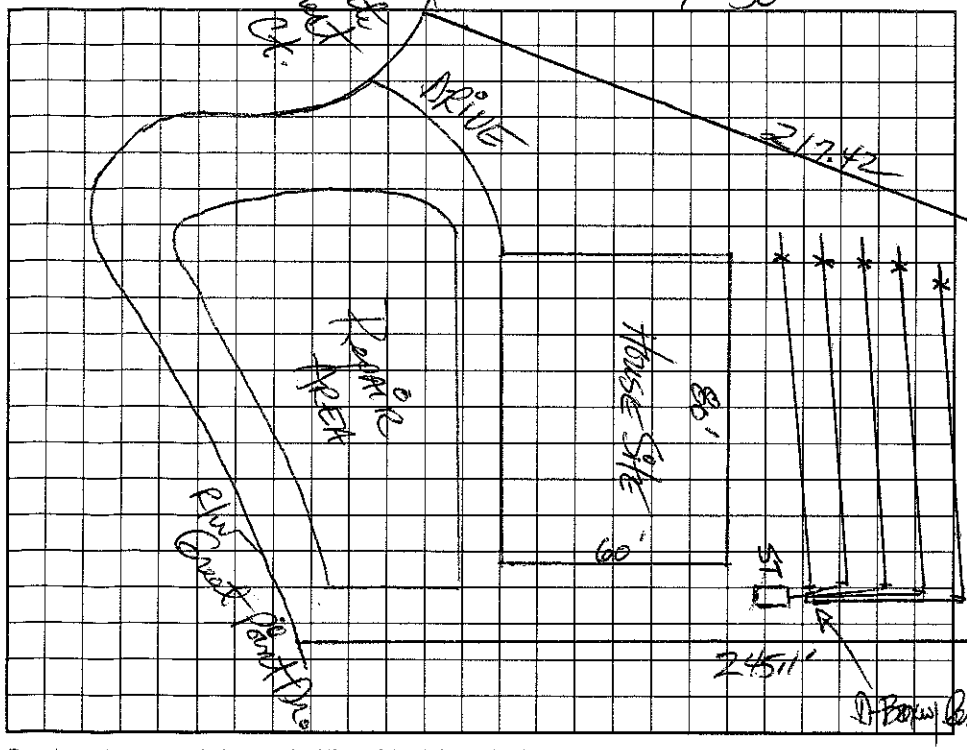

AS BUILT SKETCH

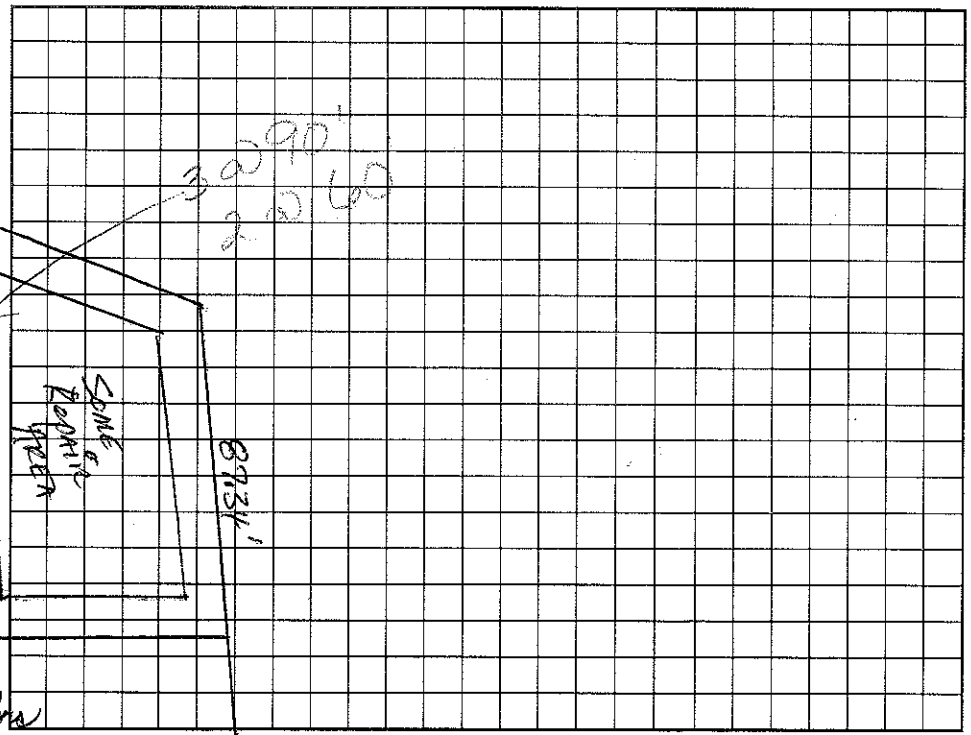

Permit can be suspended or revoked if any false information is supplied toward securing the permit/any unauthorized changes are made to the site/any unauthorized changes are made in the installation of the system. Improvement Permit with plat valid without expiration. Improvement Permit with site plan valid for sixty months. Authorization to Construct is valid for a period equal to that of Improvement Permit – not to exceed sixty months.

Signed: date 5-14-99 Installed by: R & H Inc

Improvement Permit by: date 5-7-99 Operation Permit by: date 1/26/2001

Authorization to Construct by: date 7/27/00 Existing System Inspection by: date

HEALTH DEPT. COPY: WHITE OWNER COPY (FINAL): YELLOW OWNER COPY (INITIAL): PINK