IREDELL COUNTY HEALTH DEPARTMENT

STATESVILLE 704-878-5305 125 MOORESVILLE 704-664-5281

IMPROVEMENT PERMIT / AUTHORIZATION TO CONSTRUCT / OPERATION PERMIT / EXISTING SYSTEM INSPECTIO.

PERMIT# 078675 PIN# 4625944684 (pt) 4626-80-7819 DATE June 9, '99

OWNER OR CONTRACTOR Crescent Resources/Elec. If The Pointe Assoc. PHONE: Business 660-1185 Home

ADDRESS 2214 Brawley School Rd Mooresville

LOCATION Brawley School Rd TL Great Point Drive TL Wild Harbor Rd. on left

SUBDIVISION The Point BLOCK / SECTION III LOT 367 LOT AREA 37,968 ft² SITE CLASS. 75 DESIGN FLOW 480 gpd L.T.A.R. .03

Septic Tank: 1000+ Gallons; STB 338 Date 9-17-01

Pump Tank: Gallons; PT Date

Pump Make: Model Serial No.

Nitrification Field: No Fields 1 Square Feet 1320 Linear Feet 440

No Lines 4@110' Trench Width 36" Max Trench Bottom Depth 36" Gravel Depth N/A

☑ New System ☐ Repair System Type: I, II, (III), IV, V, VI

System Description: Gravity Innovative-25%Red

Repair System Description: Same

Maintenance Agreement Required: ☐ Yes ☑ No

☑ House/Mod. Home No. Bedrooms 4

☐ Mobile Home No. Bathrooms 4

☐ Business No. Employees

☐ Other

☐ Slab ☑ Crawl Space ☐ Basement w/plumbing ☐ Basement wo/plumbing


Water Supply: ☐ Individual ☐ Public ☐ Community

Comments:/Conditions: * ONE INSPECTION/PORT PER LATERAL


Comments:/Conditions: Filter installed

1"=50'

INITIAL SITE SKETCH

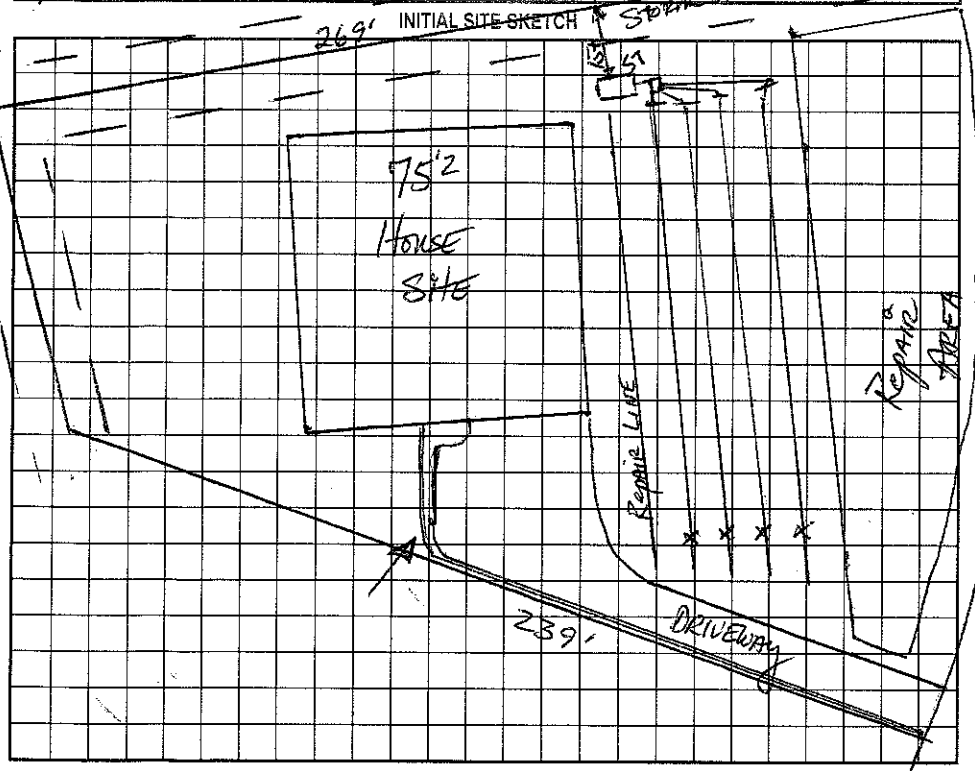

AS BUILT SKETCH

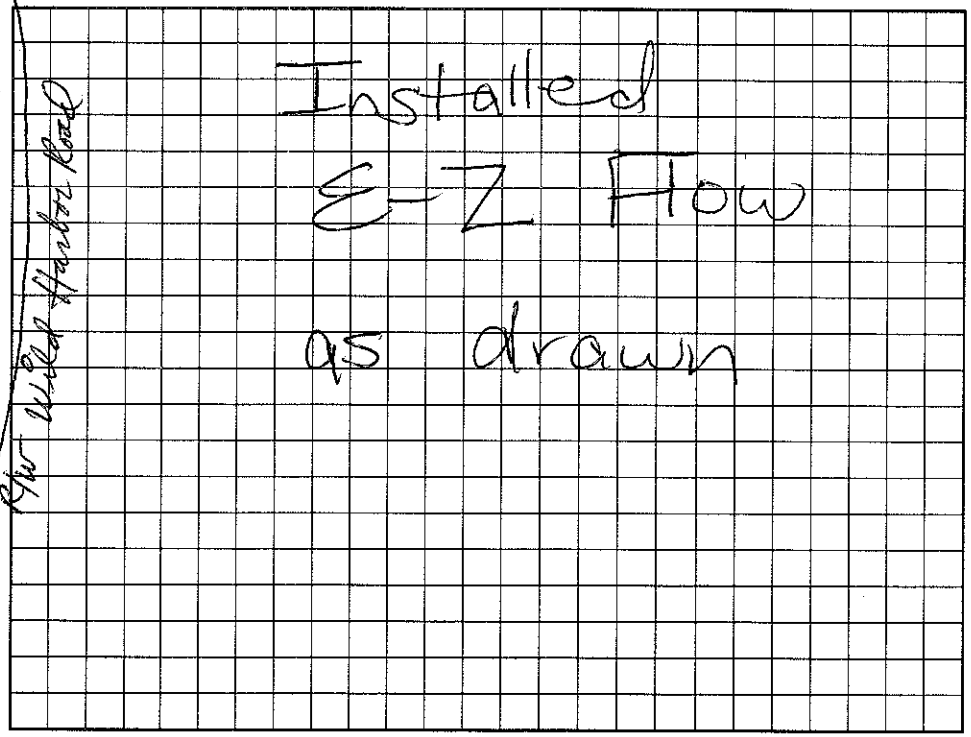

Permit can be suspended or revoked if any false information is supplied toward securing the permit/any unauthorized changes are made to the site/any unauthorized changes are made in the installation of the system. Improvement Permit with plat valid without expiration. Improvement Permit with site plan valid for sixty months. Authorization to Construct is valid for a period equal to that of Improvement Permit – not to exceed sixty months.

Signed: date 6-11-99

Improvement Permit by: date 6-9-99

Authorization to Construct by: Wesley Sparks R.S. date 5/4/01

Installed by: R & H Inc

Operation Permit by: date 11/6/2001

Existing System Inspection by: date

HEALTH DEPT. COPY: WHITE OWNER COPY (FINAL): YELLOW OWNER COPY (INITIAL): PINK