...LL COUNTY HEALTH DEPARTMENT

STATESVILLE 704-878-5305 MOORESVILLE 704-664-5281

...ROVEMENT PERMIT / AUTHORIZATION TO CONSTRUCT / OPERATION PERMIT / EXISTING SYSTEM INSPECTION

...ERMIT# 078721 PIN# 4625944684 (pt.) 4626-80-8446 DATE May 7, 99

OWNER OR CONTRACTOR Crescent Resources, LLC / The Point on Norman PHONE: Business 660-1185 Home

ADDRESS 2214 Brawley Sch. Rd. Mooresville

LOCATION Brawley Sch. Rd. TL Great Point Drive on left 1st past White Crest Ct.

SUBDIVISION The Point BLOCK / SECTION III LOT 372 LOT AREA 35,225 ft² SITE CLASS. PS DESIGN FLOW 480gpd L.T.A.R. .03

Septic Tank 1500 ~~1000~~ Gallons; STB 338 Date 2/21/00

Pump Tank: Gallons; PT Date

Pump Make: Model Serial No.

Nitrification Field: No Fields 1 Square Feet 1200 Linear Feet 400

No Lines 4 @ 100' Trench Width 36" Max Trench Bottom Depth 36"

☑ New System ☐ Repair System Type: I, II, III, IV, V, VI

System Description: GRAVITY INNOVATIVE

Repair System Description: LP ~~INNOVATIVE~~ Panel Block

Maintenance Agreement Required: ☐ Yes ☑ No

Gravel Depth NA ☐ Slab ☒ Crawl Space ☑ Basement w/plumbing ☐ Basement wo/plumbing

☑ House/Mod. Home No. Bedrooms 4

☐ Mobile Home No. Bathrooms 4

☐ Business No. Employees


☐ Other

Water Supply: ☐ Individual ☑ Public ☑ Community

Comments:/Conditions: * ONE inspection port per Lateral

Comments:/Conditions: 8-27-99 - OK to do daylight basement to right side of home w/ standard type door. Original system should go in as shown. Repair will now be LP Panel Block NO FUTURE BEDROOMS IN BASEMENT! DRH

INITIAL SITE SKETCH

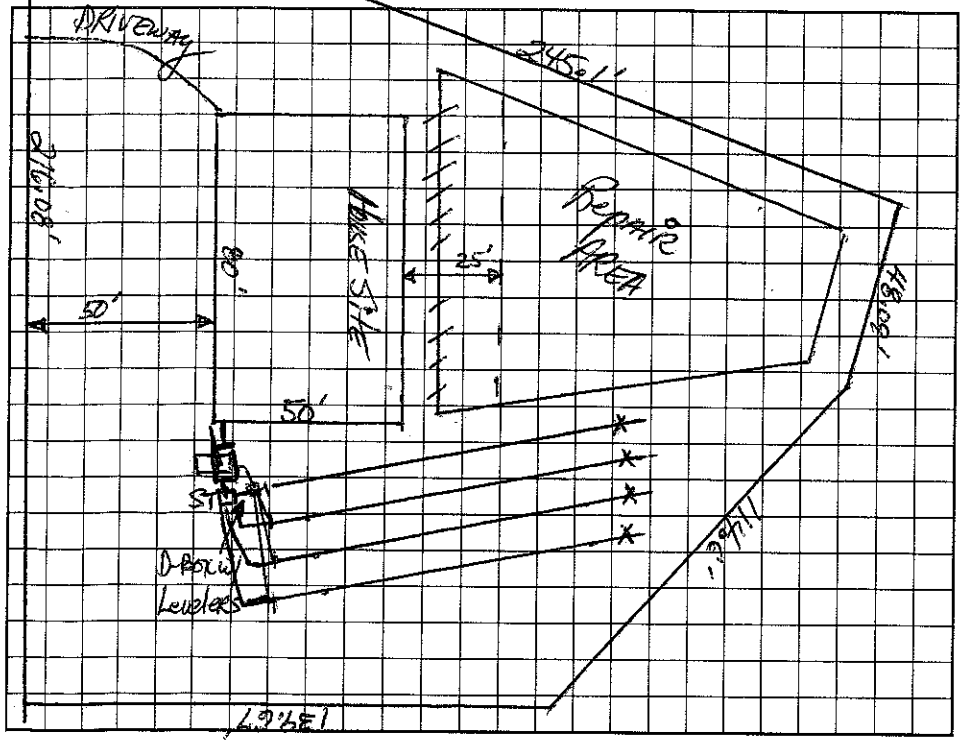

E-Z Layout AS-BUILT SKETCH

Permit can be suspended or revoked if any false information is supplied toward securing the permit/any unauthorized changes are made to the site/any unauthorized changes are made in the installation of the system. Improvement Permit with plat valid without expiration. Improvement Permit with site plan valid for sixty months. Authorization to Construct is valid for a period equal to that of Improvement Permit – not to exceed sixty months.

Signed: date 5-14-99 Installed by: Wayne Dalrison

Improvement Permit by: date 5-7-99 Operation Permit by: Wesley Sparks R.S. date 3/28/00

Authorization to Construct by: date 6-2-99 Existing System Inspection by: date

HEALTH DEPT. COPY: WHITE OWNER COPY (FINAL): YELLOW OWNER COPY (INITIAL): PINK