COPY

IREDELL COUNTY HEALTH DEPARTMENT

STATESVILLE 704-878-5305 125 MOORESVILLE 704-664-5281

IMPROVEMENT PERMIT / AUTHORIZATION TO CONSTRUCT / OPERATION PERMIT / EXISTING SYSTEM INSPECTION

PERMIT# 078717 PIN# 4625941684 (pt) 4626-80-8728 DATE June 9, '99

OWNER OR CONTRACTOR Crescent Resources/The Point/Norman PHONE: Business 660-1185 Home

ADDRESS 2214 Brawley Sch Rd Mooresville

LOCATION Brawley Sch Rd. To Great Point Drive TL Wild Harbor Road on Left

SUBDIVISION The Point BLOCK / SECTION III LOT 368 LOT AREA 32,988 ft² SITE CLASS. IS DESIGN FLOW 480 gpd L.T.A.R. n.a.3

Septic Tank: 1000+ Gallons; STB 338 Date 5-16-00
Pump Tank: 1000 Gallons; PT 27 Date 4-1-00
Pump Make: Model Serial No.
Nitrification Field: No Fields 1 Square Feet 1320 Linear Feet 440
No Lines 4@110' Trench Width 36" Max Trench Bottom Depth 36"

☑ New System ☐ Repair System Type: I, II, III, IV, V, VI
System Description: pm - INNOVATIVE - 25% Red.
Repair System Description: LP Panel Block
Maintenance Agreement Required: ☐ Yes ☑ No
Gravel Depth N/A


☑ House/Mod. Home No. Bedrooms 4
☐ Mobile Home No. Bathrooms 4
☐ Business No. Employees
☐ Other
☐ Slab ☑ Crawl Space ☐ Basement w/plumbing ☐ Basement wo/plumbing

Water Supply: ☐ Individual ☑ Public ☑ Community


Comments:/Conditions: * ONE INSPECTION PORT PER LATERAL

Comments:/Conditions: Inspected Tanks & Lines 8/2/2000
Installed as Drawn.

1"=50' INITIAL SITE SKETCH

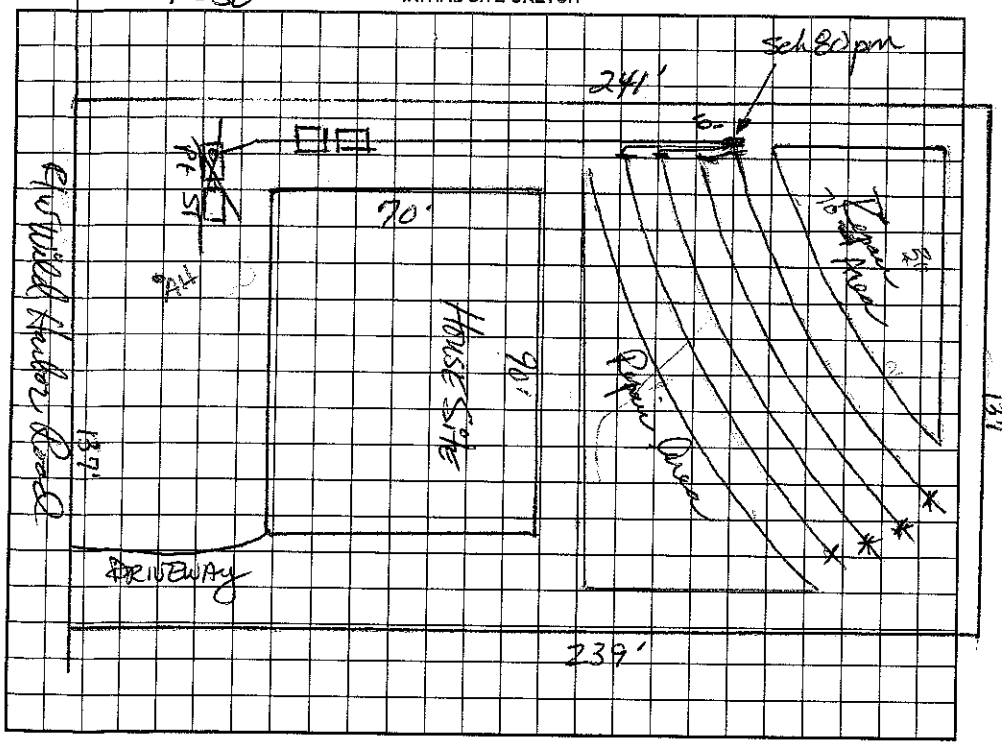

AS BUILT SKETCH

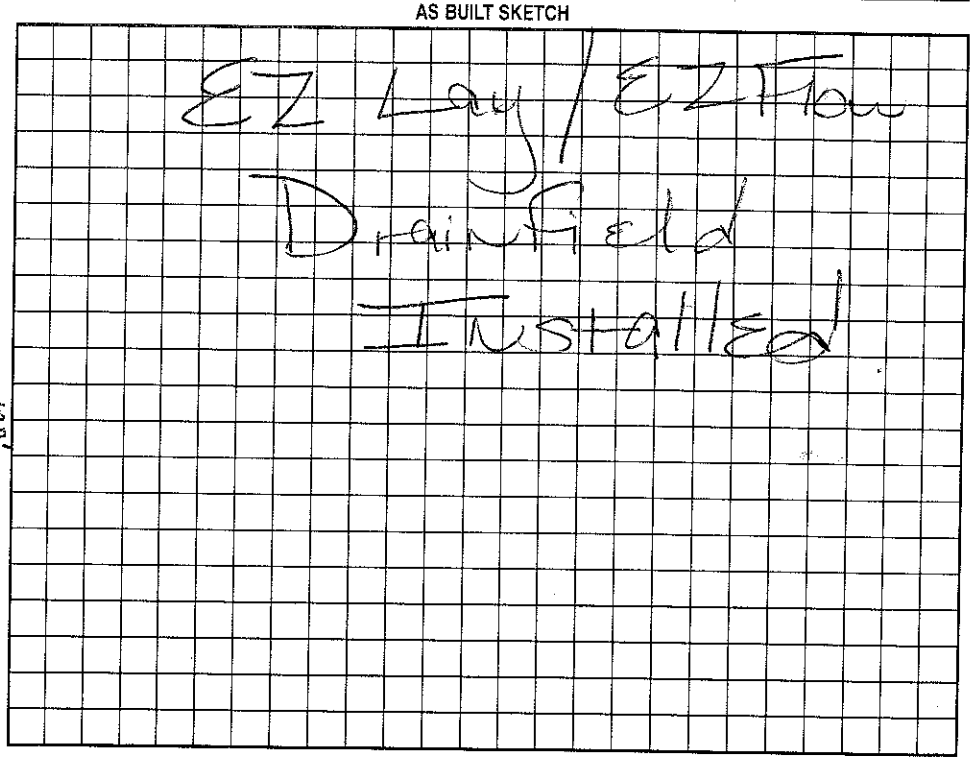

Permit can be suspended or revoked if any false information is supplied toward securing the permit/any unauthorized changes are made to the site/any unauthorized changes are made in the installation of the system. Improvement Permit with plat valid without expiration. Improvement Permit with site plan valid for sixty months. Authorization to Construct is valid for a period equal to that of Improvement Permit – not to exceed sixty months.

Signed: PEG Pat date 6-11-99
Improvement Permit by: [signature] date 6-9-99
Authorization to Construct by: [signature] date 1/14/00

Installed by: R & H Inc.
Operation Permit by: ~~Tom Stevenson~~ date
Existing System Inspection by: Operation Marina Dobson date 1/26/2001

HEALTH DEPT. COPY: WHITE OWNER COPY (FINAL): YELLOW OWNER COPY (INITIAL): PINK