IREDELL COUNTY HEALTH DEPARTMENT

STATESVILLE 704-878-5305 125 MOORESVILLE 704-664-5281

IMPROVEMENT PERMIT / AUTHORIZATION TO CONSTRUCT / OPERATION PERMIT / EXISTING SYSTEM INSPECTION

PERMIT# 028717 PIN# 4625941684 (pt) 4626-80-8728 DATE June 9, '99

OWNER OR CONTRACTOR Crescent Resources/The Point/Tom Norman PHONE: Business 660-1185 Home

ADDRESS 2214 Brawley Sch Rd Mooresville

LOCATION Brawley Sch Rd. TL Goat Point Drive TL Wild Harbor Road on Left

SUBDIVISION The Point BLOCK / SECTION III LOT 368 LOT AREA 32,988 sf SITE CLASS. S DESIGN FLOW 480 gpd L.T.A.R. no 3

Septic Tank: 1000+ Gallons; STB 338 Date 5-16-00
Pump Tank: 1000 Gallons; PT 27 Date 4-1-00
Pump Make: Model Serial No.
Nitrification Field: No Fields 1 Square Feet 1320 Linear Feet 440
No Lines 4@110' Trench Width 36" Max Trench Bottom Depth 36"

☒ New System ☐ Repair System Type: I, II, III, IV, V, VI
System Description: PM - INNOVATIVE - 25% Red
Repair System Description: LP Panel Block
Maintenance Agreement Required: ☐ Yes ☒ No
Gravel Depth NA

☐ House/Mod. Home No. Bedrooms 4
☐ Mobile Home No. Bathrooms 4
☐ Business No. Employees
☐ Other
☐ Slab ☒ Crawl Space ☐ Basement w/plumbing ☐ Basement wo/plumbing


Water Supply: ☐ Individual ☒ Public ☐ Community

Comments/Conditions: * ONE INSPECTION PORT PER LATERAL

Comments/Conditions: Inspected Tanks & Lines 8/2/2000
Installed as Drawn.

1"=50'

INITIAL SITE SKETCH

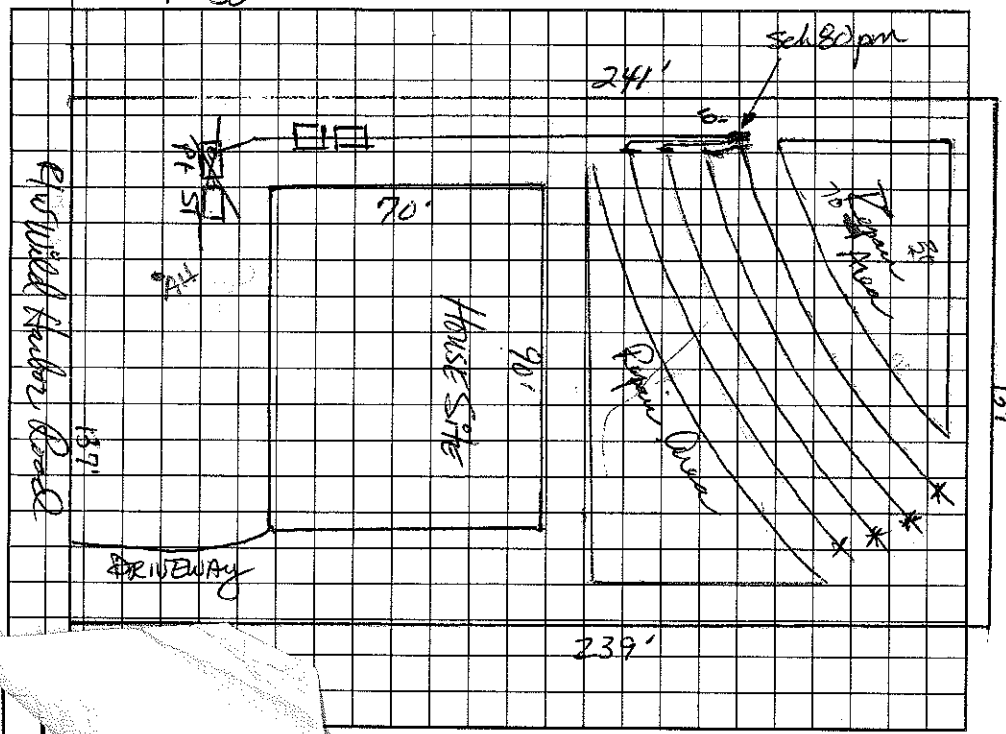

AS BUILT SKETCH

EZ Lay / EZ Flow
Drainfield
Installed

If any false information is supplied toward securing the permit/any unauthorized changes are made to the site/any unauthorized changes are made in the installation of the system. Improvement. Improvement Permit with site plan valid for sixty months. Authorization to Construct is valid for a period equal to that of Improvement Permit – not to exceed sixty months.

date 6-11-99
date 6-9-99
date 1/14/00

Installed by: R & H Inc.
Operation Permit by: Tom Stevenson date
Existing System Inspection by: Marina Dobson date 1/14/00

HEALTH DEPT. COPY: WHITE OWNER COPY (FINAL): YELLOW OWNER COPY (INITIAL): PINK