IREDELL COUNTY HEALTH DEPARTMENT

STATESVILLE 704-878-5305 MOORESVILLE 704-664-5281

IMPROVEMENT PERMIT / AUTHORIZATION TO CONSTRUCT / OPERATION PERMIT / EXISTING SYSTEM INSPECTION

PERMIT# 078-18 PIN# ~~4625941684~~ PT 4626-80-9720 DATE 9/18/2000

OWNER OR CONTRACTOR CRI / Augusta Homes PHONE: Business 634-0845 Rex Talbott Home

ADDRESS 2214 Brawley School Rd, Mooresville, NC

LOCATION Brawley School Rd TL Great Point Dr TL Wild Harbor Rd on left

SUBDIVISION The Point BLOCK / SECTION III LOT 369 LOT AREA 28,824 SITE CLASS. PS DESIGN FLOW 480gpd L.T.A.R. .3

Septic Tank: 1000+ Gallons; STB 338 Date 1-16-01
Pump Tank: 1000 Gallons; PT 27338 Date 8-2-99
Pump Make: Meyers Model ME50 Serial No.
Nitrification Field: No Fields 1 Square Feet 810' Linear Feet 270'
No Lines 3 @ 90' Trench Width 36" Max Trench Bottom Depth 30" Gravel Depth N/A

☒ New System ☐ Repair System Type: I, II, III, IV, V, VI
System Description: Panel (Pumped LP)
Repair System Description: Pumped LP Panel
Maintenance Agreement Required: ☒ Yes ☐ No


☒ House/Mod. Home No. Bedrooms 4
☐ Mobile Home No. Bathrooms 4
☐ Business No. Employees
☐ Other
☐ Slab ☒ Crawl Space ☐ Basement w/plumbing ☐ Basement wo/plumbing

Water Supply: ☐ Individual ☒ Public ☐ Community

Comments:/Conditions: Remove old terrace. Keep Septic System 10' from PL, 5' From House & 15' From Pool.

Comments:/Conditions: Filter not installed yet. 3/20/2001 Center Feed, Drain Lines. Press. Alarm & Elect.

INITIAL SITE SKETCH Scale = 1:40'

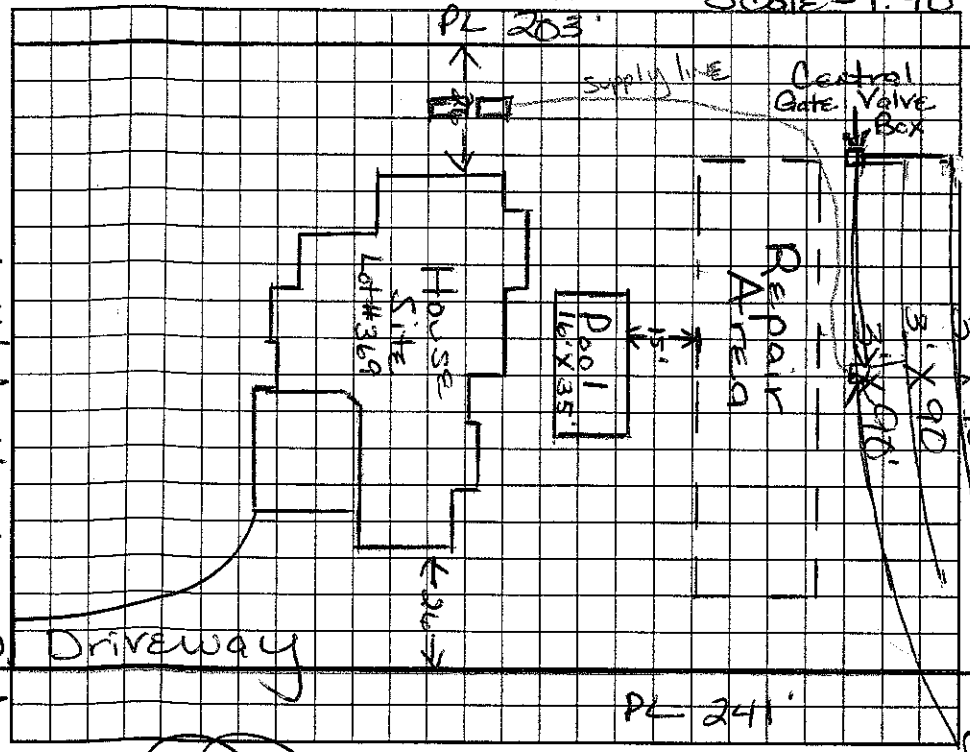

AS BUILT SKETCH

Installed as Drawn

Permit can be suspended or revoked if any false information is supplied toward securing the permit/any unauthorized changes are made to the site/any unauthorized changes are made in the installation of the system. Improvement Permit with plat valid without expiration. Improvement Permit with site plan valid for sixty months. Authorization to Construct is valid for a period equal to that of Improvement Permit – not to exceed sixty months.

Signed: _____ date _____

Improvement Permit by: Maria H. H. Talbott RS date 9/18/00

Authorization to Construct by: Maria H. H. Talbott RS date 9/18/00

Installed by: R & H

Operation Permit by: Maria H. H. Talbott RS date 4/24/01

Existing System Inspection by: _____ date _____

HEALTH DEPT. COPY: WHITE OWNER COPY (FINAL): YELLOW OWNER COPY (INITIAL): PINK