125

IREDELL COUNTY HEALTH DEPARTMENT

STATESVILLE 704-878-5305 MOORESVILLE 704-664-5281

IMPROVEMENT PERMIT / AUTHORIZATION TO CONSTRUCT / OPERATION PERMIT / EXISTING SYSTEM INSPECTION

PERMIT# 07809 PIN# 4625944684 (pt.) DOBBLE CONST. 4626-81-1553 DATE May 13 '99

OWNER OR CONTRACTOR Crescent Resources dba/ The Point on Norman PHONE: Business 660-4185 Home

ADDRESS 2214 Brawley Sch Rd. Mooresville

LOCATION Brawley Sch Rd. TL Great Point Drive TL Wild Harbor Road on Right

SUBDIVISION The Point BLOCK / SECTION III LOT 305 ~~305A~~ LOT AREA 46329 sf + 5FE305A** SITE CLASS. ** PS DESIGN FLOW 480 gpd L.T.A.R. no. 3

Septic Tank ~~1500~~ 1000 Gallons; STB 338 Date 2/5/03

Pump Tank: 1000 Gallons; PT 283 Date 2/5/03

Pump Make: Myers Model ME 100 S 2.1 Serial No.

Nitrification Field: No Fields 1 Square Feet 1350 Linear Feet 450

No Lines 5@90' Trench Width 36" Max Trench Bottom Depth 36" Gravel Depth N/A

☑ New System ☐ Repair System Type: I, II, III, IV, V, VI

System Description: PM-INNOVATIVE-25% Reduction

Repair System Description: Same/LP INNOVATIVE

Maintenance Agreement Required: ☐ Yes ☑ No

☑ House/Mod. Home ☐ Mobile Home ☐ Business ☐ Other

No. Bedrooms 4 No. Bathrooms 4 No. Employees


☐ Slab ☐ Crawl Space ☑ Basement w/plumbing ☐ Basement wo/plumbing

Water Supply: ☐ Individual ~~☐ Public~~ ☐ Community

Comments:/Conditions: * one inspection per per lateral

Comments:/Conditions:

INITIAL SITE SKETCH 1"=100'

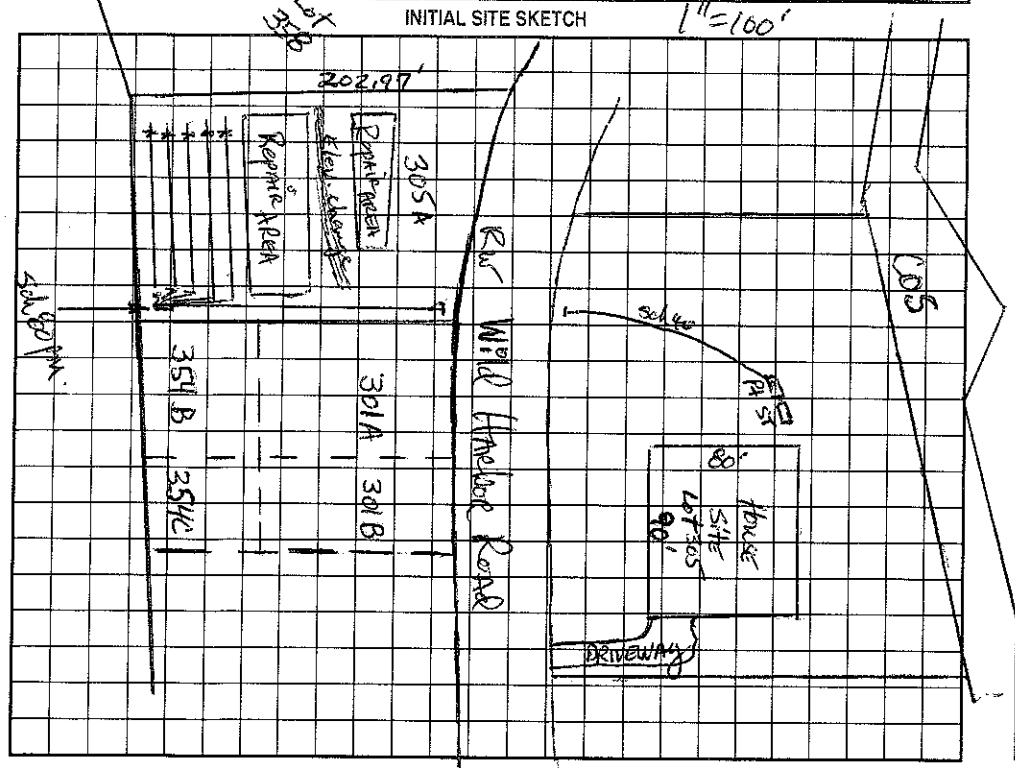

AS BUILT SKETCH

Permit can be suspended or revoked if any false information is supplied toward securing the permit/any unauthorized changes are made to the site/any unauthorized changes are made in the installation of the system. Improvement Permit with plat valid without expiration. Improvement Permit with site plan valid for sixty months. Authorization to Construct is valid for a period equal to that of Improvement Permit – not to exceed sixty months.

Signed: [signature] date 5-14-99 Installed by: Johnson Const.

Improvement Permit by: [signature] RS date 5-13-99 Operation Permit by: Wesley Sparks R.S. date 4/2/03

Authorization to Construct by: Wesley Sparks R.S. date 6/28/02 Existing System Inspection by: date

HEALTH DEPT. COPY: WHITE OWNER COPY (FINAL): YELLOW OWNER COPY (INITIAL): PINK