IREDELL COUNTY HEALTH DEPARTMENT

STATESVILLE 704-878-5305 50.00 Paid MOORESVILLE 704-664-5281

IMPROVEMENT PERMIT / AUTHORIZATION TO CONSTRUCT / OPERATION PERMIT / EXISTING SYSTEM INSPECTI

PERMIT# 078670 PIN# 4625 94 1684 (Pt.) 4626-81-2018 DATE 11/13/6

OWNER OR CONTRACTOR Kingswood Homes PHONE: Business 704-506-3456 Home

ADDRESS 8044 Corporate Center Dr. Ste 400 Charlotte, NC. 28226

LOCATION 1100 TL Great Point Drive TL Wild Harbor Rd. on (L) at jct with Coral Bell Ct.

SUBDIVISION Pointe BLOCK / SECTION 3 LOT 362 LOT AREA ~47000 ft² SITE CLASS: PS DESIGN FLOW 600 L.T.A.R. 3

Septic Tank: 1500 Gallons: STB 338 Date 3-16-03
Pump Tank: 1500 Gallons: PT 338 Date 3-2-03
Pump Make: Goulds Model WED 712 HU Serial No. CO337284
Nitrification Field: No Fields 1 Square Feet 1500 * Linear Feet 500 *
No Lines 5@100' Trench Width 3 Max Trench Bottom Depth 3 Gravel Depth No

[X] New System [ ] Repair System Type: I, II, [III], IV, V, VI
System Description: PumpMan → 25% Reduced
Repair System Description: 16" PPBPS
Maintenance Agreement Required: [ ] Yes [X] No
[ ] Slab [X] Crawl Space [ ] Basement w/plumbing [ ] Basement wo/plumbing


[X] House/Mod. Home No. Bedrooms 5
[ ] Mobile Home No. Bathrooms 4
[ ] Business No. Employees
[ ] Other

Water Supply: [ ] Individual [X] Public [X] Community


Comments:/Conditions: (1" = 50')

Comments:/Conditions: Polylok filter installed, MD Tanks, lines & pressure checked 5/4/03 EZ Flow Drainfield

INITIAL SITE SKETCH

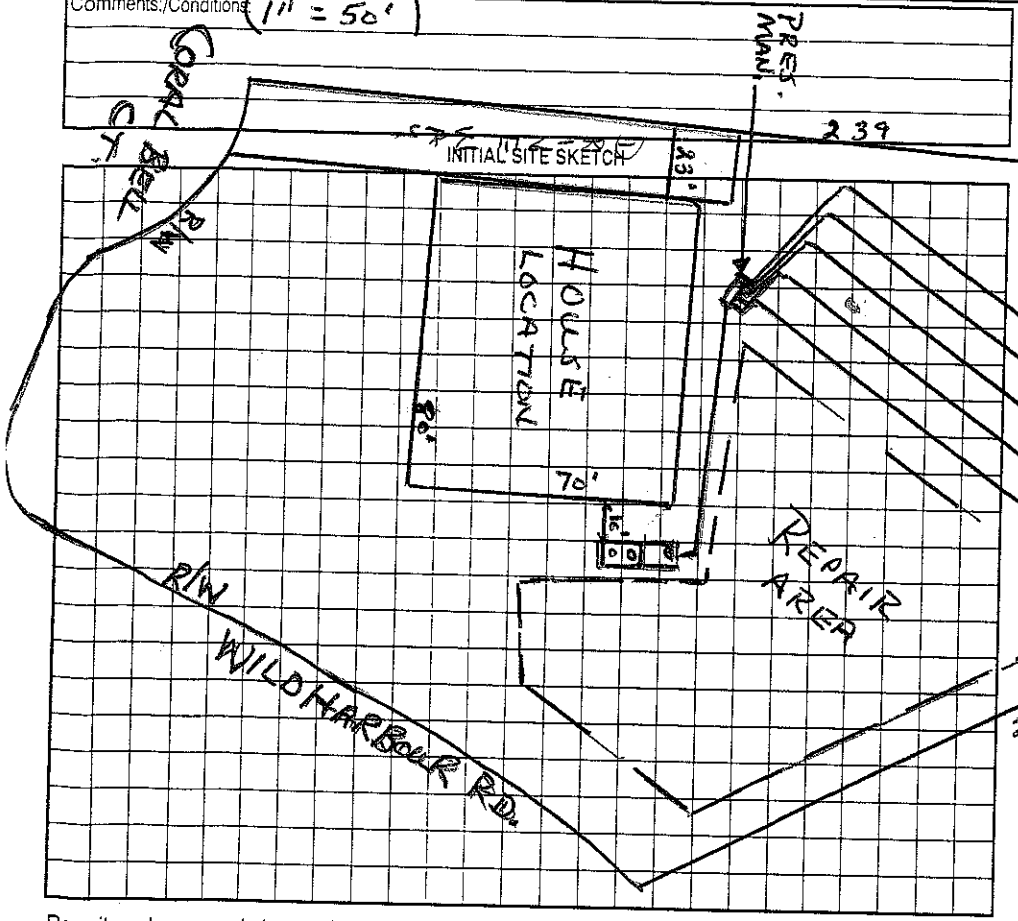

AS BUILT SKETCH

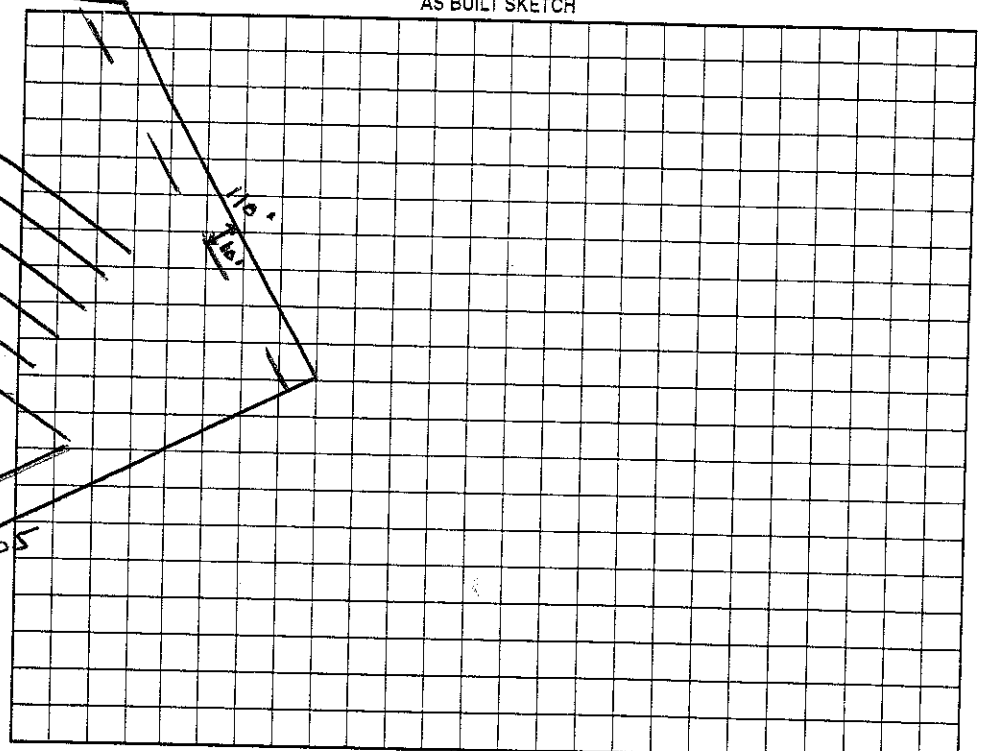

Permit can be suspended or revoked if any false information is supplied toward securing the permit/any unauthorized changes are made to the site/any unauthorized changes are made in the installation of the system. Improvement Permit with plat valid without expiration. Improvement Permit with site plan valid for sixty months. Authorization to Construct is valid for a period equal to that of Improvement Permit – not to exceed sixty months.

Signed: [signature] date 11-22-02 Installed by: Hallman Construction

Improvement Permit by: Wesley Sparks RS. date 11/13/02 Operation Permit by: [signature] RS date 6/16/03

Authorization to Construct by: Wesley Sparks RS. date 11/13/02 Existing System Inspection by: date

HEALTH DEPT. COPY: WHITE OWNER COPY (FINAL): YELLOW OWNER COPY (INITIAL): PINK