IREDELL COUNTY HEALTH DEPARTMENT

STATESVILLE 704-878-5305 MOORESVILLE 704-664-5281

IMPROVEMENT PERMIT / AUTHORIZATION TO CONSTRUCT / OPERATION PERMIT / EXISTING SYSTEM INSPECTION

PERMIT# 078508 PIN# ~~4625 94 1684 (PT)~~ 4626-81-2367 DATE 9/11/02

OWNER OR CONTRACTOR Dibble Building PHONE: Business 660-1185 Home

ADDRESS PO Box 2355 Cornelius, NC. 28031

LOCATION Brawley Sch. Tr Great Pointe Dr. Tr Wild Harbor Rd. on (R)

SUBDIVISION Pointe BLOCK / SECTION III LOT 304 LOT AREA > 38,000 SITE CLASS PS DESIGN FLOW 480 L.T.A.R. .25

Septic Tank: 1500 Gallons; STB 3388 Date 12/9/02
Pump Tank: 1000 Gallons; PT 312 Date 12/9/02
Pump Make: Model Serial No.
Nitrification Field: No Fields 1 Square Feet 960 Linear Feet 320
No Lines 3@ Trench Width 2-3' Max Trench Bottom Depth 36" Gravel Depth

[X] New System [ ] Repair System Type: I, II, III, (IV), V, VI
System Description: Pressure - 16" PPBPS
Repair System Description: Same
Maintenance Agreement Required: [X] Yes [ ] No


[X] House/Mod. Home No. Bedrooms 4
[ ] Mobile Home No. Bathrooms 4
[ ] Business No. Employees
[ ] Other
[ ] Slab [ ] Crawl Space [X] Basement w/plumbing [ ] Basement wo/plumbing

Water Supply: [ ] Individual [ ] Public [X] Community

Comments:/Conditions:

Comments:/Conditions:

INITIAL SITE SKETCH

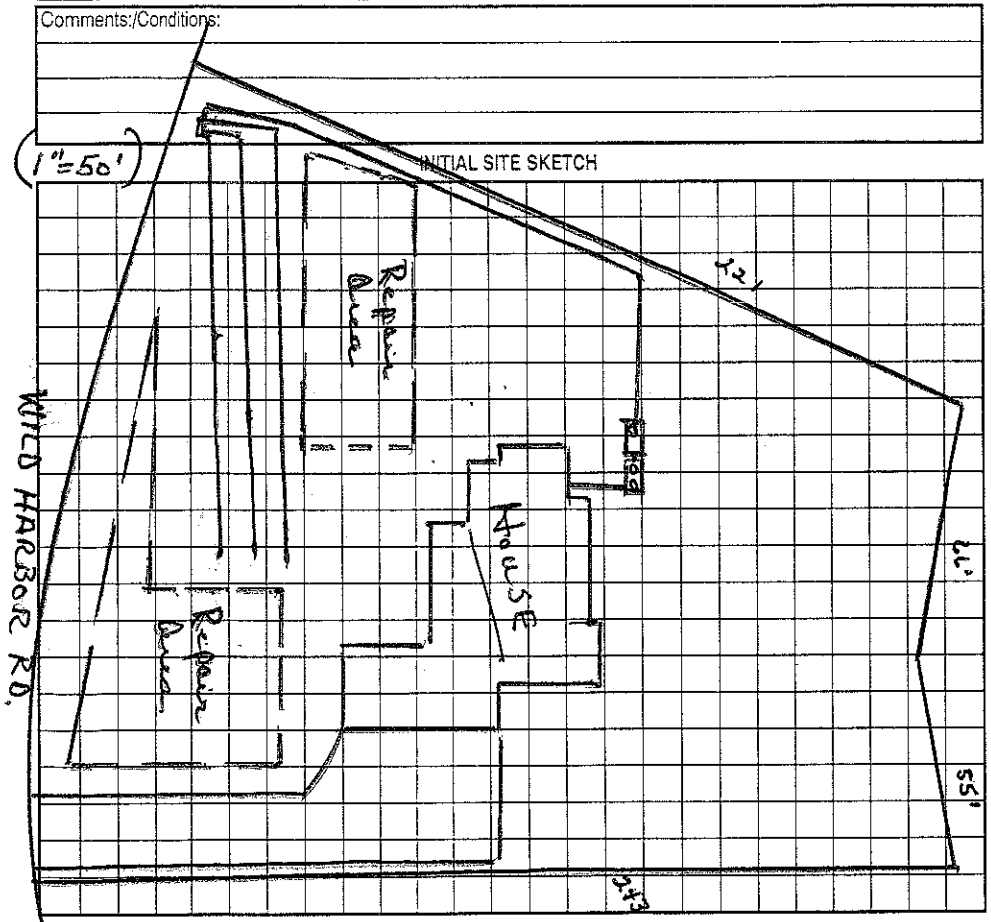

AS BUILT SKETCH

Permit can be suspended or revoked if any false information is supplied toward securing the permit/any unauthorized changes are made to the site/any unauthorized changes are made in the installation of the system. Improvement Permit with plat valid without expiration. Improvement Permit with site plan valid for sixty months. Authorization to Construct is valid for a period equal to that of Improvement Permit – not to exceed sixty months.

Signed: *Crystal Dibble date Installed by: Orbison

Improvement Permit by: Wesley Sparks RS. date 9/11/02 Operation Permit by: RS date 9/27/03

Authorization to Construct by: Wesley Sparks RS. date 9/11/02 Existing System Inspection by: date

HEALTH DEPT. COPY: WHITE OWNER COPY (FINAL): YELLOW OWNER COPY (INITIAL): PINK