IREDELL COUNTY HEALTH DEPARTMENT

STATESVILLE 704-878-5305 #245 MOORESVILLE 704-664-5281

IMPROVEMENT PERMIT / AUTHORIZATION TO CONSTRUCT / OPERATION PERMIT / EXISTING SYSTEM INSPECTION

PERMIT# 078510 PIN# ~~4625 94 7884 PL~~ 4626-81-2857 DATE 12/16/02

OWNER OR CONTRACTOR Dibble Const. Co. PHONE: Business 704-799-1688 Home

ADDRESS PO Box 2355 Cornelius NC, 28031

LOCATION 1100 Tl Great Point Dr. Tl Wild Harbor Rd on (R) 222 W Wild Harbor Rd

SUBDIVISION Point BLOCK / SECTION 3 LOT 309 LOT AREA 62,241 FT² SITE CLASS PS DESIGN FLOW 600 L.T.A.R. .25

Septic Tank: 1500 Gallons; STB 338 Date 6/17/03
Pump Tank: 1500 Gallons; PT 338 Date 6/15/03
Pump Make: Gould's Model WE1012 HH Serial No. 3/26/03
Nitrification Field: No Fields 1 Square Feet 800 - 1200 Linear Feet 400
No Lines ~~40 100~~ Trench Width 2' - 3' Max Trench Bottom Depth 3' Gravel Depth NA

☒ New System ☐ Repair System Type: I, II, III (IV) V, VI
System Description: Pressured - 16" PPBPS
Repair System Description: 16" PPBPS
Maintenance Agreement Required: ☒ Yes ☐ No


☒ House/Mod. Home No. Bedrooms 5
☐ Mobile Home No. Bathrooms
☐ Business No. Employees
☐ Other
☐ Slab ☐ Crawl Space ☒ Basement w/plumbing ☐ Basement wo/plumbing

Water Supply: ☐ Individual ☒ Public ☒ Community


Comments:/Conditions: 5

Comments:/Conditions: 110', 100', 80', 75', 35'
10/1 Heavy vehicle have been driven across the drainfield area

INITIAL SITE SKETCH

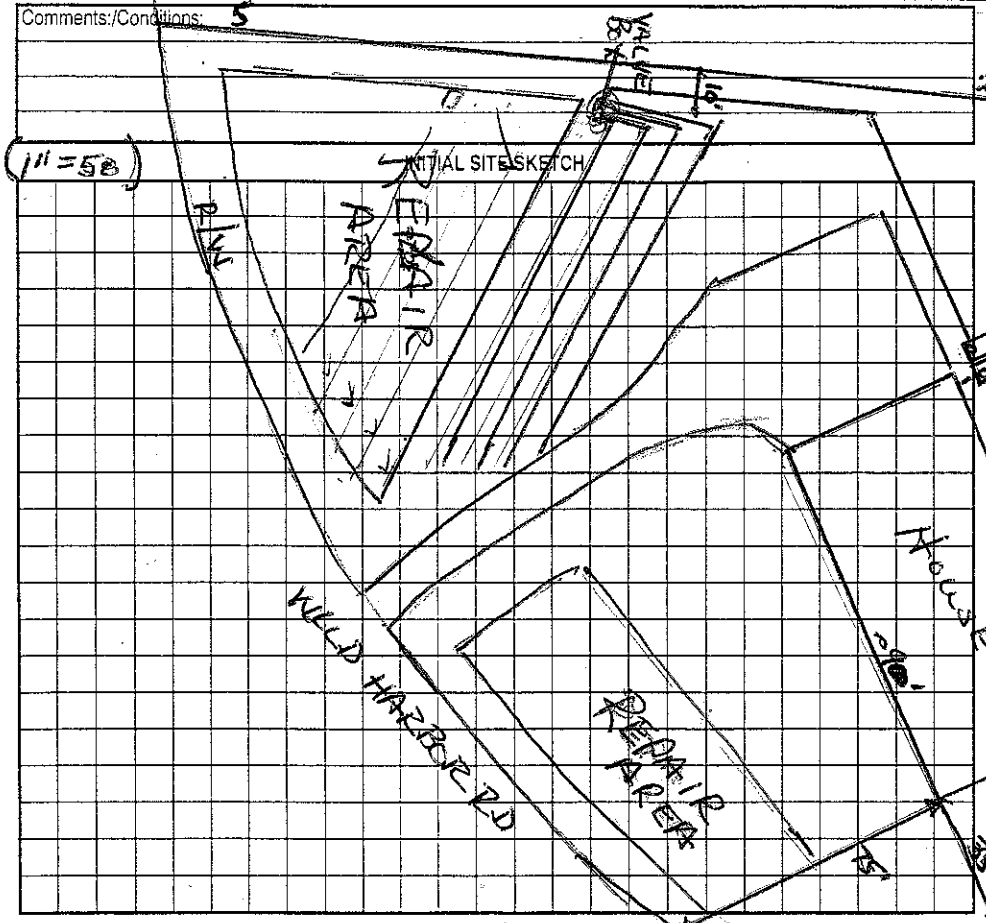

AS BUILT SKETCH

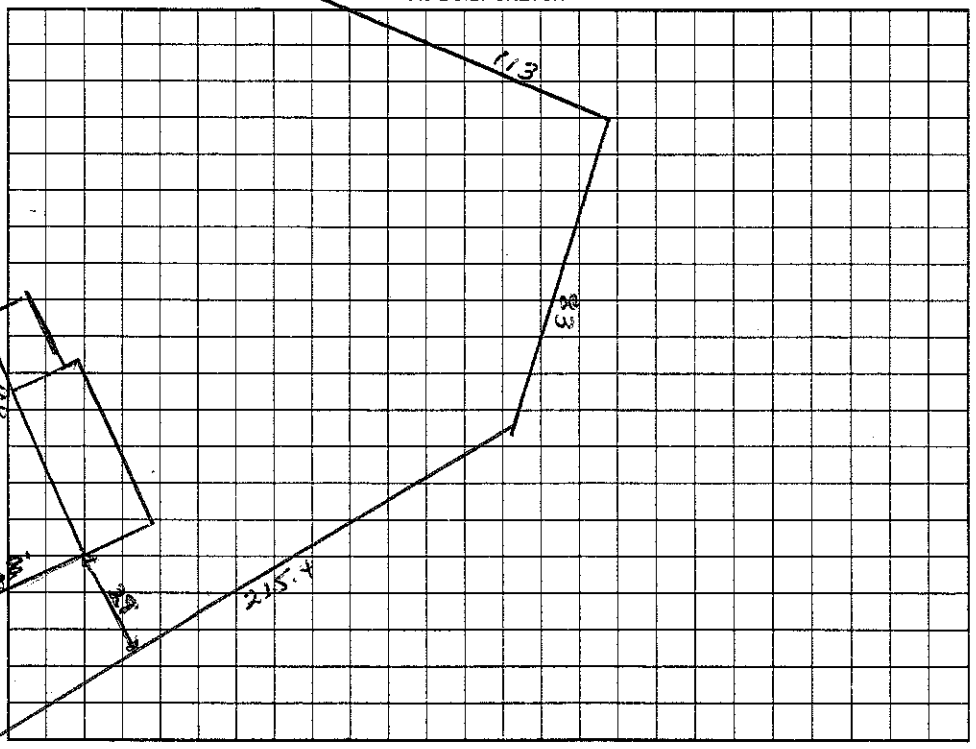

Permit can be suspended or revoked if any false information is supplied toward securing the permit/any unauthorized changes are made to the site/any unauthorized changes are made in the installation of the system. Improvement Permit with plat valid without expiration. Improvement Permit with site plan valid for sixty months. Authorization to Construct is valid for a period equal to that of Improvement Permit – not to exceed sixty months.

Signed: Crayton D Dibble date

Improvement Permit by: Wesley Sparks RS. date 12/16/02

Authorization to Construct by: Wesley Sparks RS. date 12/16/02

Installed by: Dobson

Operation Permit by: Wesley Sparks RS. date 10/2/03

Existing System Inspection by: date

HEALTH DEPT. COPY: WHITE OWNER COPY (FINAL): YELLOW OWNER COPY (INITIAL): PINK