125

IREDELL COUNTY HEALTH DEPARTMENT

STATESVILLE 704-878-5305 MOORESVILLE 704-664-5281

IMPROVEMENT PERMIT / AUTHORIZATION TO CONSTRUCT / OPERATION PERMIT / EXISTING SYSTEM INSPECTION

PERMIT# 078506 PIN# 4625944684 (pt) 4626 81 4283 DATE May 12, 199

OWNER OR CONTRACTOR Crescent Resources c/o The Point Golf Course PHONE: Business 660-1185 Home

ADDRESS 3214 Brawley Sch Rd. Mooresville

LOCATION Brawley Sch Rd. TL Great Point Drive TR Wild Harbor Road on Right

SUBDIVISION The Point BLOCK / SECTION III LOT 302 LOT AREA 69,239 ft² SITE CLASS PS DESIGN FLOW 480gpd L.T.A.R. 0.25

Septic Tank: 1500 Gallons; STB 338 Date 9/11/01
Pump Tank: 1000 Gallons; PT 27 Date 9/9/01
Pump Make: Goulds Model GO1 58356 Serial No.
Nitrification Field: No Fields 1 Square Feet 1500 Linear Feet 500
No Lines 5@100 Trench Width 36" Trench Bottom Depth 48" Gravel Depth N/A

☑ New System ☐ Repair System Type: I, II, III, IV, V, VI
System Description: 0M - INNOVATIVE - 25% Red.
Repair System Description: LP INNOVATIVE
Maintenance Agreement Required: ☐ Yes ☑ No

☑ House/Mod. Home No. Bedrooms 4
☐ Mobile Home No. Bathrooms 4
☐ Business No. Employees
☐ Other

☑ Slab ☑ Crawl Space ☑ Basement w/plumbing ☐ Basement wo/plumbing


Water Supply: ☐ Individual ☑ Public ☐ Community

Comments/Conditions: INSTALL LATERALS AT 48" FROM bottom depth.


Comments/Conditions: (ACTUAL) 5/30/02 - Heavy Vehicle around Tanks and drainfield. Installed "Plastic Chambers" 5 lines

1"=50'

INITIAL SITE SKETCH

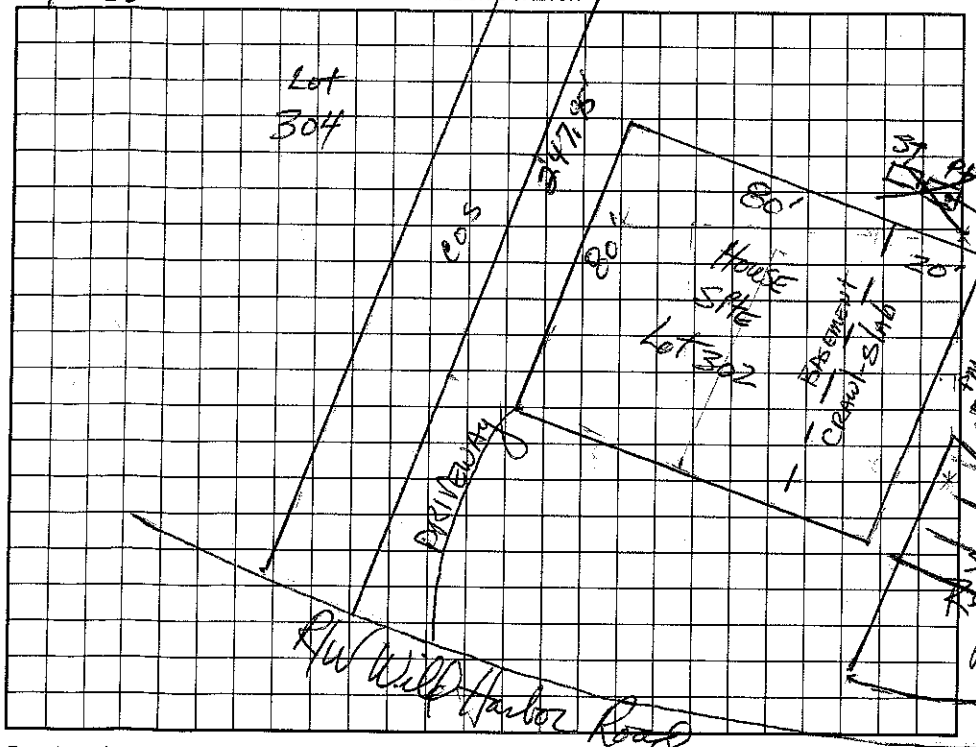

AS BUILT SKETCH

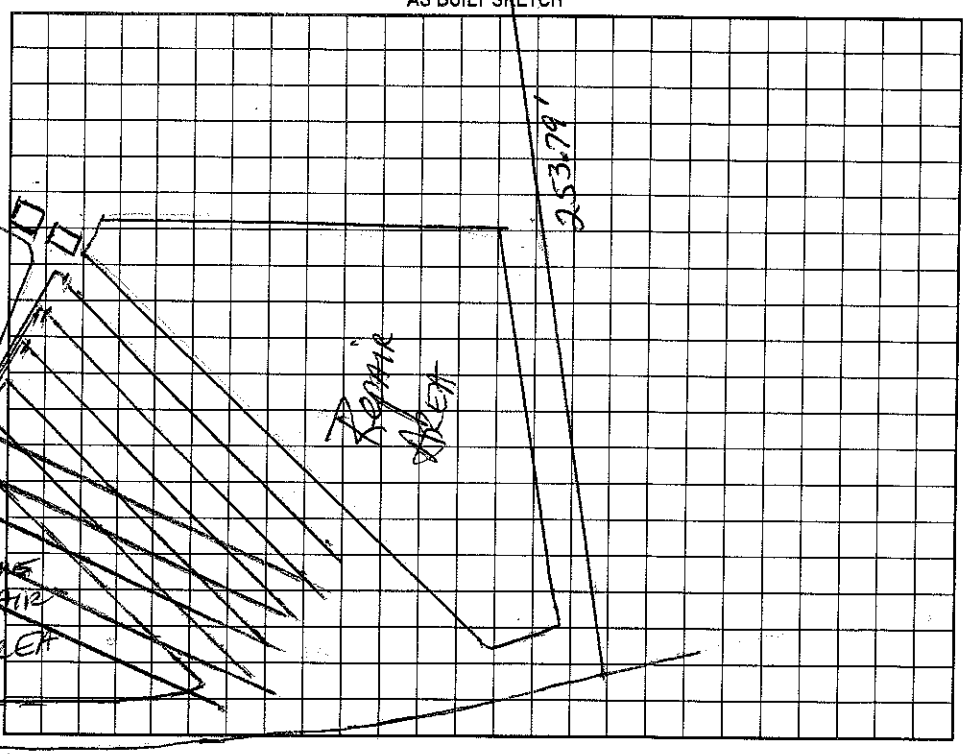

Permit can be ~~suspended~~ or revoked if any false information is supplied toward securing the permit/any unauthorized changes are made to the site/any unauthorized changes are made in the installation of the system. Improvement Permit with plat valid without expiration. Improvement Permit with site plan valid for sixty months. Authorization to Construct is valid for a period equal to that of Improvement Permit – not to exceed sixty months.

Signed: [signature] date 5-14-01 Installed by: Wayne Orbison

Improvement Permit by: [signature] RS date 5-12-99 Operation Permit by: [signature] RS date 5/30/02

Authorization to Construct by: [signature] RS date 6/7/01 Existing System Inspection by: date

HEALTH DEPT. COPY: WHITE OWNER COPY (FINAL): YELLOW OWNER COPY (INITIAL): PINK