IREDELL COUNTY HEALTH DEPARTMENT

STATESVILLE 704-878-5305 2450.00 Paid 2.00 MOORESVILLE 704-664-5281

IMPROVEMENT PERMIT / AUTHORIZATION TO CONSTRUCT / OPERATION PERMIT / EXISTING SYSTEM INSPECTION

PERMIT# 078515 PIN# ~~4625944684 pt.~~ 4626-81-4575 DATE 7/3/02

OWNER OR CONTRACTOR Cornerstone Builders PHONE: Business 704-889-8229 Home

ADDRESS 315 S. Main Pineville NC 28134

LOCATION Brawley sch, TL Brent Pt. Dr., TL Wild Harbor, TR Atlantic Way at end

SUBDIVISION Point BLOCK / SECTION 3 LOT 313/313A LOT AREA 56973 SITE CLASS PS DESIGN FLOW 600 L.T.A.R. 0.25

Septic Tank: 1500 Gallons; STB 338 Date 10/11/04
Pump Tank: 1500 Gallons; PT 477 Date 10/12/04
Pump Make: Cowles Model WE20-12 Serial No. K04 43536
Nitrification Field: No Fields 1 Square Feet 1200 Linear Feet 400
No Lines 4@100 Trench Width 36" Max Trench Bottom Depth 36" Gravel Depth —

☒ New System ☐ Repair System Type: I, II, III, (IV), V, VI
System Description: LP Panel Block
Repair System Description: Same
Maintenance Agreement Required: ☒ Yes ☐ No

☒ House/Mod. Home No. Bedrooms 5
☐ Mobile Home No. Bathrooms 4½
☐ Business No. Employees
☐ Other


☐ Slab ☐ Crawl Space ☒ Basement w/plumbing ☐ Basement wo/plumbing

Water Supply: ☐ Individual ☐ Public ☒ Community


Comments:/Conditions:

Comments:/Conditions:

INITIAL SITE SKETCH

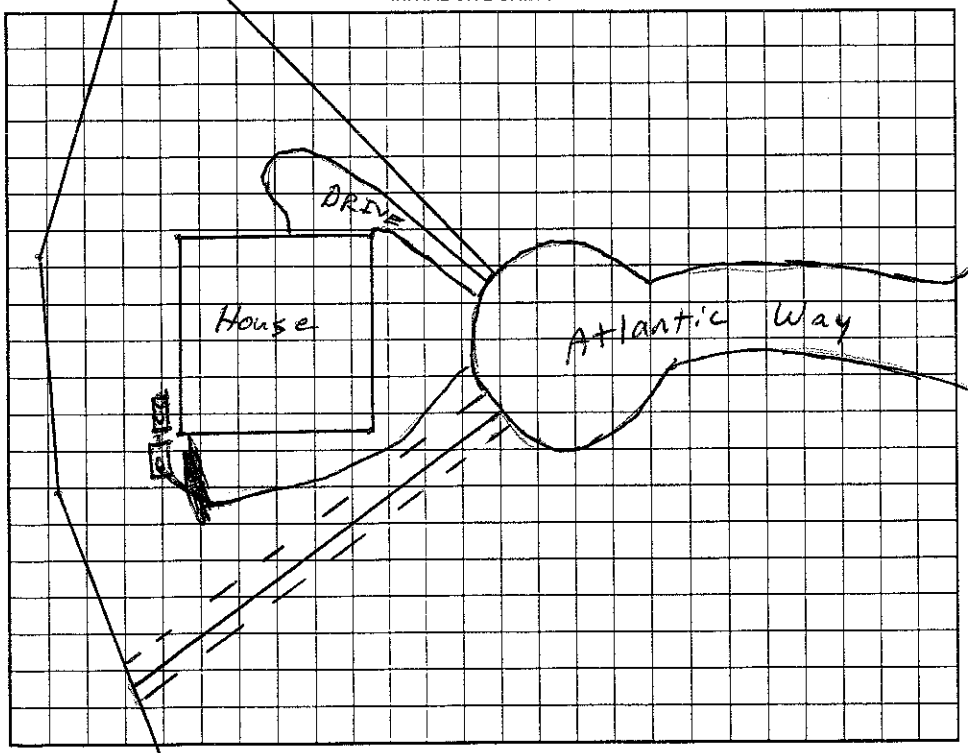

AS BUILT SKETCH

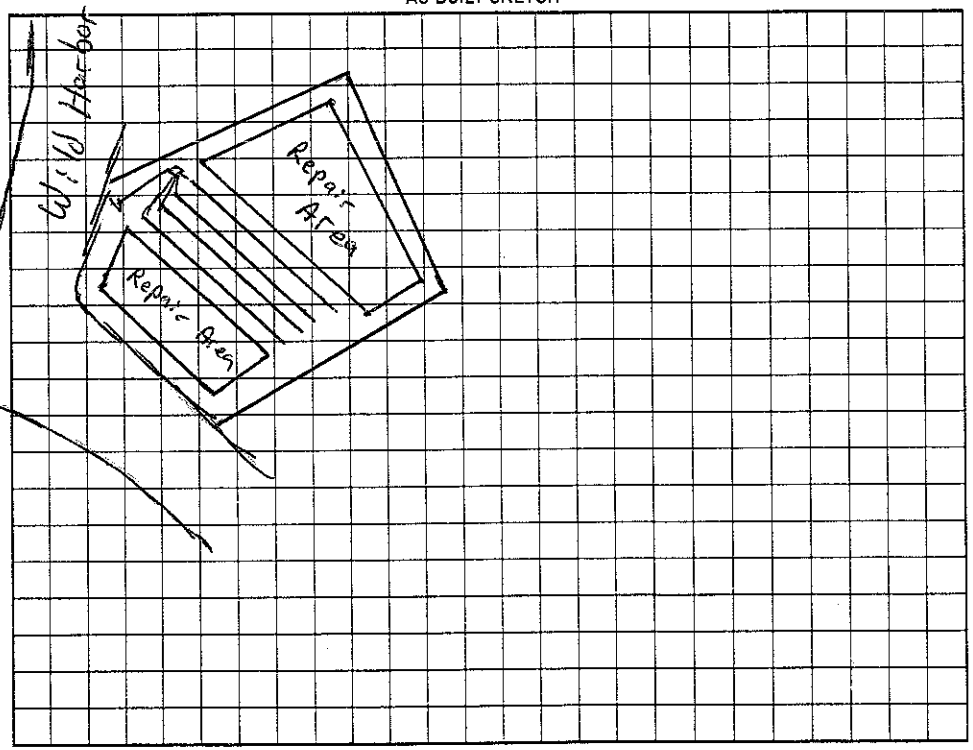

Permit can be suspended or revoked if any false information is supplied toward securing the permit/any unauthorized changes are made to the site/any unauthorized changes are made in the installation of the system. Improvement Permit with plat valid without expiration. Improvement Permit with site plan valid for sixty months. Authorization to Construct is valid for a period equal to that of Improvement Permit – not to exceed sixty months.

Signed: _____ date 8/29/02 Installed by: Hallman Const.

Improvement Permit by: _____ date 7/3/02 Operation Permit by: Wesley Sparkman ES date 1/20/05

Authorization to Construct by: _____ date 7/3/02 Existing System Inspection by: _____ date _____

HEALTH DEPT. COPY: WHITE OWNER COPY (FINAL): YELLOW OWNER COPY (INITIAL): PINK