-361-9707-Brad

IREDELL COUNTY HEALTH DEPARTMENT

STATESVILLE 704-878-5305 MOORESVILLE 704-664-5281

IMPROVEMENT PERMIT / AUTHORIZATION TO CONSTRUCT / OPERATION PERMIT / EXISTING SYSTEM INSPECTION

PERMIT# 078517 PIN# 4625944684 (PT) 4626-81-7508 Rick DATE 11-15-2001

OWNER OR CONTRACTOR Simonini Builders PHONE: Business 201-8976 Home

ADDRESS 817 E. Morehead St. Charlotte, NC 28202

LOCATION Brawley School Rd TL Great Point TL Wild Harbour TR Atlantic Way on left 104

SUBDIVISION The Point BLOCK / SECTION III LOT 314 LOT AREA 1.58 Acres SITE CLASS. PS DESIGN FLOW 600gpd L.T.A.R. .25

Septic Tank: 1500 Gallons; STB 338 Date 4-23-02 ☒ New System ☐ Repair System Type: I, II, III, IV, V, VI

Pump Tank: 1500 Gallons; PT 338 Date 4-23-02 System Description: Pump-LP-Panel Block

Pump Make: Model Serial No. Repair System Description: Same

Nitrification Field: No Fields 1 Square Feet 800' Linear Feet 400' Maintenance Agreement Required: ☒ Yes ☐ No

No Lines 6 Trench Width 24" Max Trench Bottom Depth 30" Gravel Depth N/A

☒ House/Mod. Home No. Bedrooms 5

☐ Mobile Home No. Bathrooms 6

☐ Business No. Employees

☐ Other (5 baths 2-½ baths)

☐ Slab ☐ Crawl Space ☒ Basement w/plumbing ☐ Basement wo/plumbing

Water Supply: ☐ Individual ☒ Public ☒ Community

Comments:/Conditions:


Okay to switch driveway to other side. Some Repair

Comments:/Conditions: Note: Installer Should use 92 Panels = 400 Ft. Keep drainlines at least 15' from road Cut & 10' From PL.


Tanks checked 5/3/02 Press, Elect & alarm 5/22/02

Scale = 1:50

INITIAL SITE SKETCH

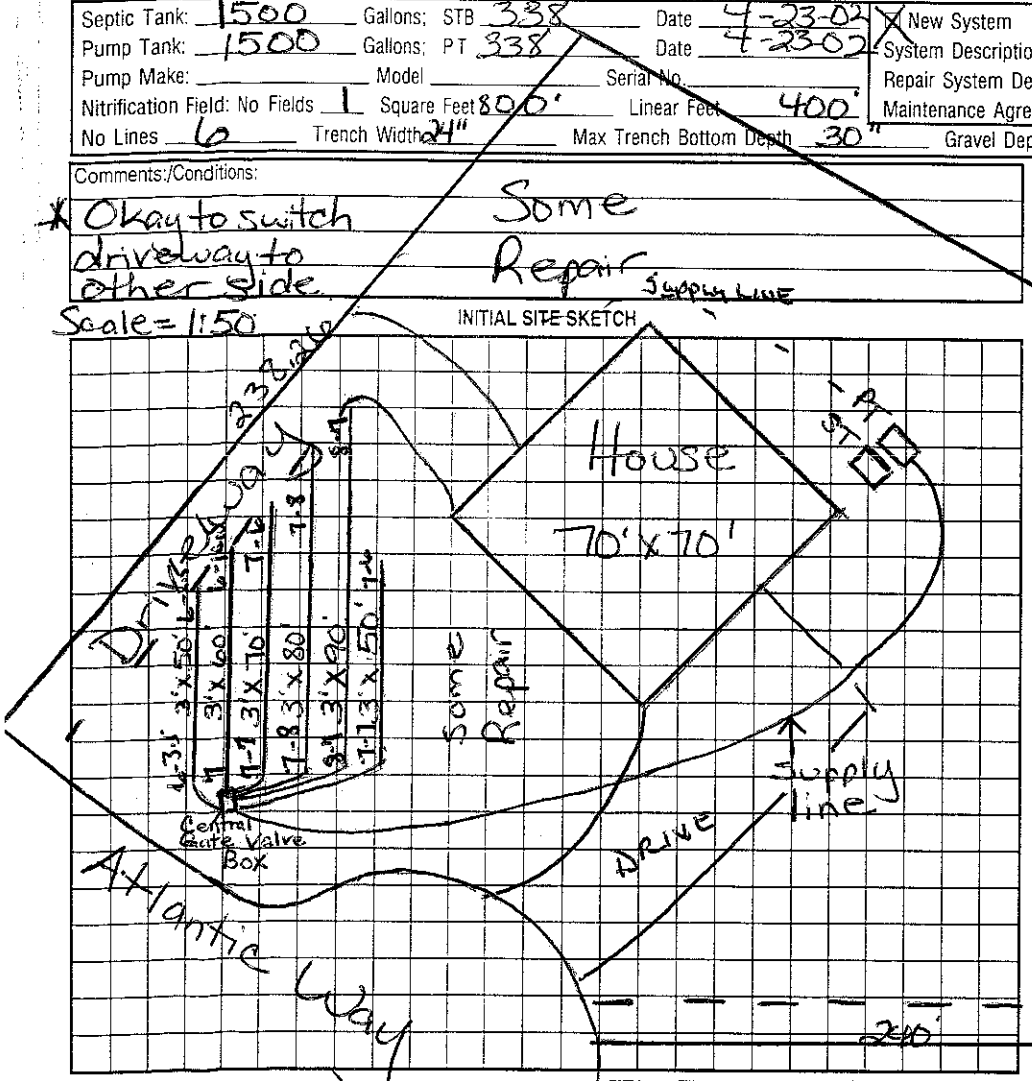

AS BUILT SKETCH

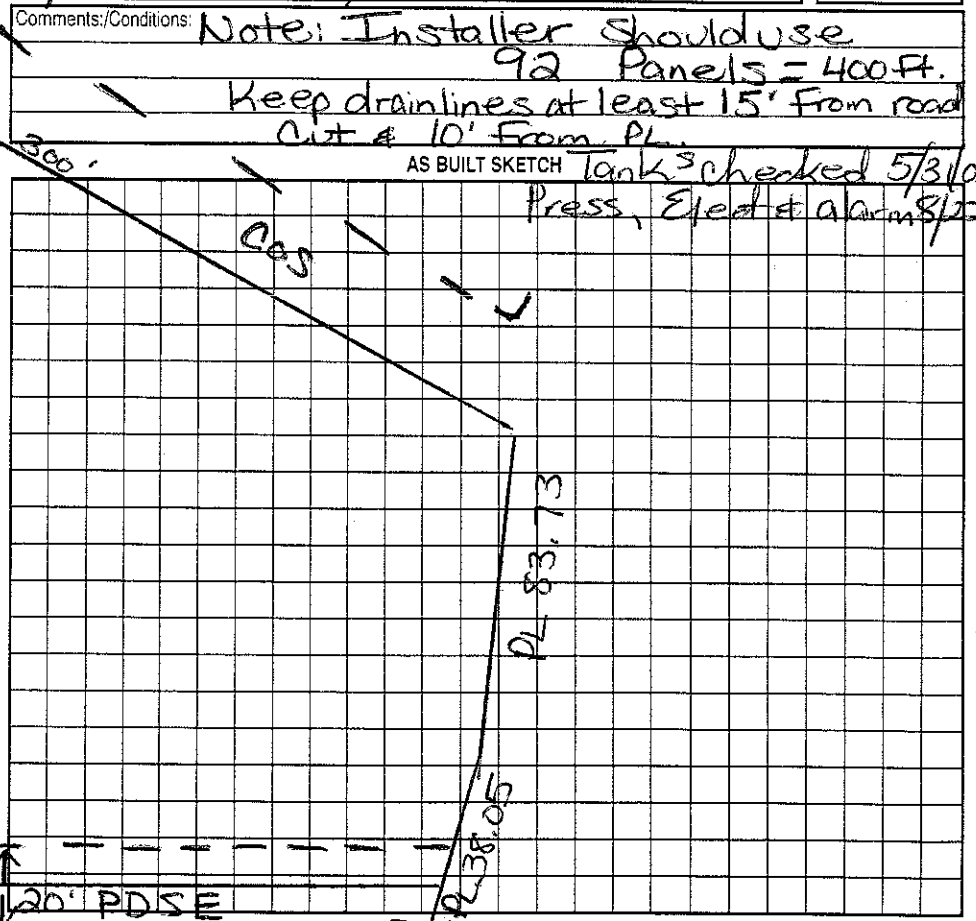

Permit can be suspended or revoked if any false information is supplied toward securing the permit/any unauthorized changes are made to the site/any unauthorized changes are made in the installation of the system. Improvement Permit with plat valid without expiration. Improvement Permit with site plan valid for sixty months. Authorization to Construct is valid for a period equal to that of Improvement Permit – not to exceed sixty months.

Signed: Dan D. Ernest date 11/19/01 Installed by: R + H Plmg.

Improvement Permit by: Myra H. Dotson RS date 11/15/01 Operation Permit by: Myra H. Dotson RS date 5/22/2002

Authorization to Construct by: Myra H. Dotson RS date 11/15/01 Existing System Inspection by: date

HEALTH DEPT. COPY: WHITE OWNER COPY (FINAL): YELLOW OWNER COPY (INITIAL): PINK