IREDELL COUNTY HEALTH DEPARTMENT

Paid 200.00 DT

STATESVILLE 704-878-5305 MOORESVILLE 704-664-5281

IMPROVEMENT PERMIT / AUTHORIZATION TO CONSTRUCT / OPERATION PERMIT / EXISTING SYSTEM INSPECTION

PERMIT# 78519 PIN# ~~4625941684 (AT)~~ 4626-81-8708 DATE 7/27/00

OWNER OR CONTRACTOR CL&T / DAVID DIBBLE CUSTOM HOMES PHONE: Business 892-5730 Home

ADDRESS PO BOX 2355 CORNELIUS 28031

LOCATION BRAWLEY SCHOOL - TL GREAT POINT DR. - TL WILD HARBOR - TL ATLANTIC WAY - ON RT

SUBDIVISION POINT BLOCK / SECTION III LOT 316 LOT AREA 36,472 ft² SITE CLASS. RS DESIGN FLOW 600GPD L.T.A.R. .25 gpd/ft²

Septic Tank: 1500 Gallons: STB 338 Date 3-2-01

Pump Tank: 1500 Gallons: PT 338 Date 12-2-01

Pump Make: ~~PACE~~ Zoeller Model W E 1612H Serial No. B614754

Nitrification Field: No Fields 1 Square Feet 1200 Linear Feet 400

No Lines 5@80' Trench Width 36" Max Trench Bottom Depth 36" Gravel Depth N/A

☑ New System ☐ Repair System Type: I, II, III (IV) V, VI

System Description: PUMP PANEL

Repair System Description: SAME

Maintenance Agreement Required: ☑ Yes ☐ No

☑ House/Mod. Home No. Bedrooms 5

☐ Mobile Home No. Bathrooms 5

☐ Business No. Employees

☐ Other


☑ Slab ☑ Crawl Space ☑ Basement w/plumbing ☐ Basement wo/plumbing

Water Supply: ☐ Individual ☐ Public ☑ ~~Community~~

Comments:/Conditions: 4/23/01 - Changed to 600 GPD from Conventional Valve Box - Accs.

Comments:/Conditions: Filter installed & many risers Checked tanks & lines 4/27/00 MO Press. 4/30/2001

INITIAL SITE SKETCH 1"=50'

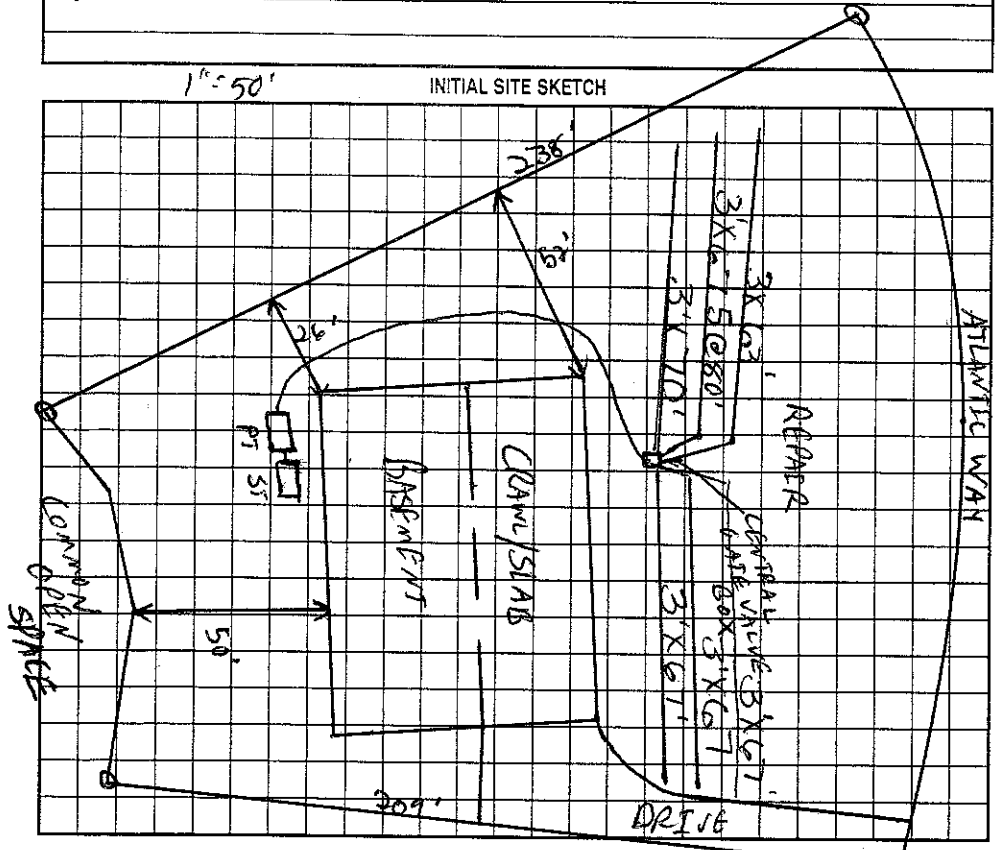

AS BUILT SKETCH

Permit can be suspended or revoked if any false information is supplied toward securing the permit/any unauthorized changes are made to the site/any unauthorized changes are made in the installation of the system. Improvement Permit with plat valid without expiration. Improvement Permit with site plan valid for sixty months. Authorization to Construct is valid for a period equal to that of Improvement Permit – not to exceed sixty months.

Signed: Crystal Dibble date 8/17/00 Installed by: Wayne Orbison

Improvement Permit by: C. Bly Jr. RS date 7/27/00 Operation Permit by: [signature] RSE date 6/12/01

Authorization to Construct by: C. Bly Jr. RS date 7/27/00 Existing System Inspection by: date

HEALTH DEPT. COPY: WHITE OWNER COPY (FINAL): YELLOW OWNER COPY (INITIAL): PINK