IREDELL COUNTY HEALTH DEPARTMENT

STATESVILLE 704-878-5305 50.00 Paid MOORESVILLE 704-664-5281 11:30

IMPROVEMENT PERMIT / AUTHORIZATION TO CONSTRUCT / OPERATION PERMIT / EXISTING SYSTEM INSPECTION

PERMIT# 078523 PIN# ~~4625941684 (pt)~~ Mobile 4626081940 3 DATE 11-9-2000

OWNER OR CONTRACTOR Crescent Resources / ~~Arcadia~~ PHONE: Business 201-7181 Home

ADDRESS P.O. Box 471441 Charlotte, NC 28247

LOCATION Brawley School Rd TL Great Point Dr. TL Wild Harbor Rd TL Atlantic Way (320A on right) Lot in Breakwater

SUBDIVISION The Point BLOCK / SECTION 3 LOT 320/320A LOT AREA SITE CLASS. PS DESIGN FLOW 600gpd L.T.A.R. ~.25 (SFE 320A)

Septic Tank: 1500 Gallons; STB 338 Date 5-14-01
Pump Tank: 1500 Gallons; PT 797 Date 1-11-99
Pump Make: Model Serial No.
Nitrification Field: No Fields 1 Square Feet 1800' Linear Feet 600'
No Lines 5 at 120' Trench Width 36" Max Trench Bottom Depth 36"

☒ New System ☐ Repair System Type: I, II, III, IV, V, VI
System Description: Pump-(pm) 25% Reduction
Repair System Description: Pump - Innovative (Panel Blk)
Maintenance Agreement Required: ☐ Yes ☒ No
Gravel Depth N/A


☒ House/Mod. Home No. Bedrooms 5
☐ Mobile Home No. Bathrooms 4½
☐ Business No. Employees
☐ Other
☐ Slab ☒ Crawl Space ☐ Basement w/plumbing ☐ Basement wo/plumbing

Water Supply: ☐ Individual ☒ Public ☒ Community


Comments:/Conditions: * One inspection port per lateral.
Keep Septic System 10' From PL & 5' From House.

Comments:/Conditions: EZ Flow lines installed lines.

INITIAL SITE SKETCH Scale 1:100'

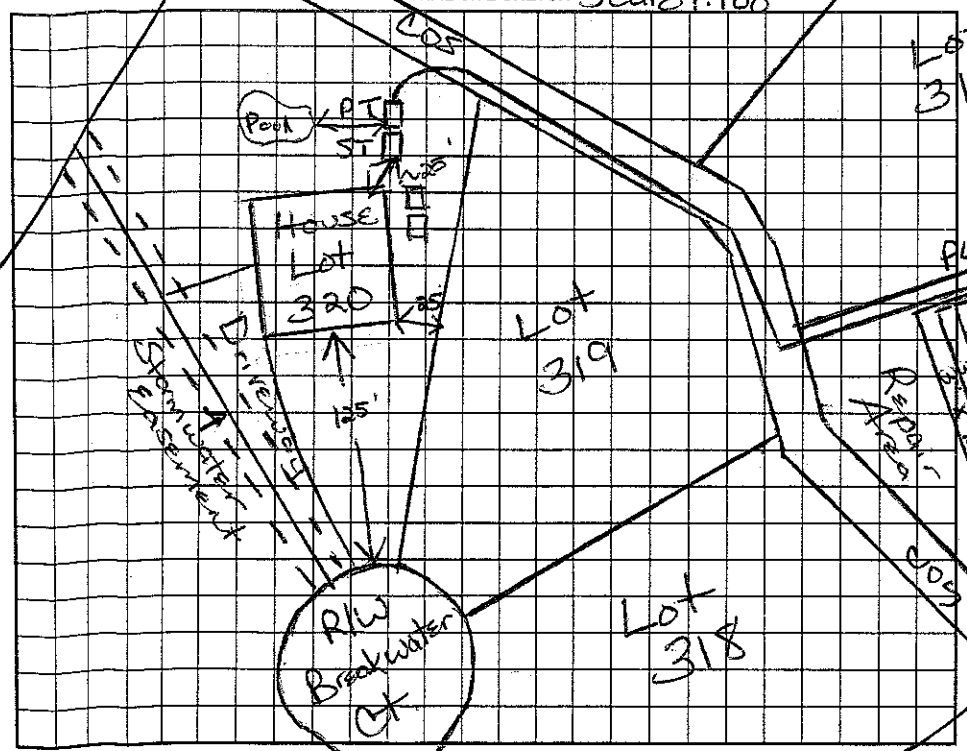

AS BUILT SKETCH

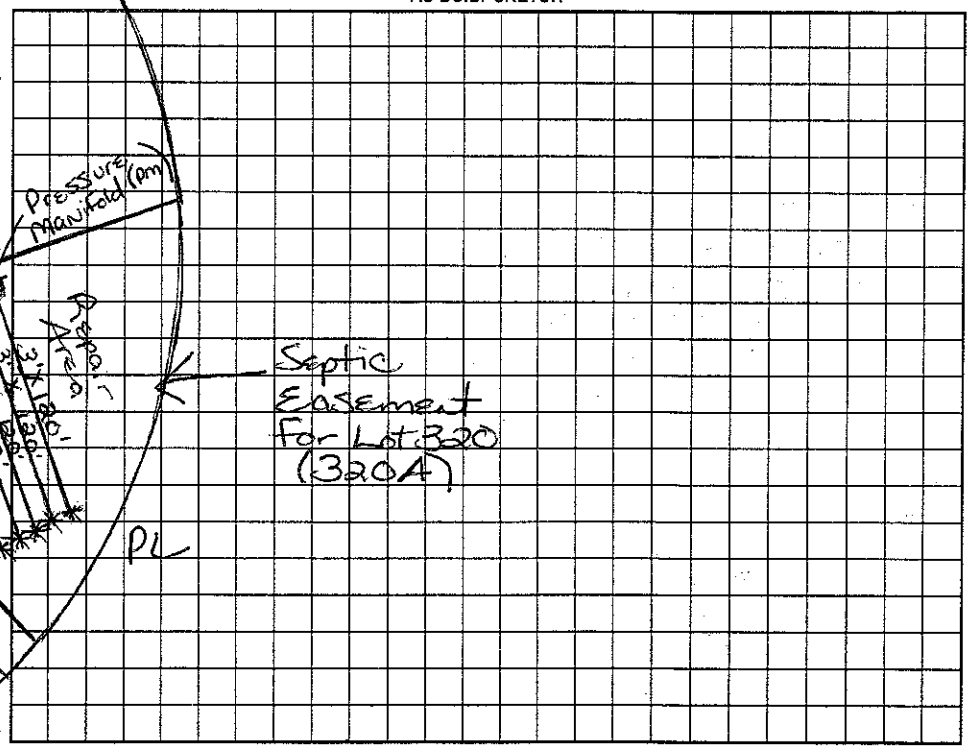

Permit can be suspended or revoked if any false information is supplied toward securing the permit/any unauthorized changes are made to the site/any unauthorized changes are made in the installation of the system. Improvement Permit with plat valid without expiration. Improvement Permit with site plan valid for sixty months. Authorization to Construct is valid for a period equal to that of Improvement Permit – not to exceed sixty months.

Signed: Vicki Potts date 11-17-00 Installed by: R&H

Improvement Permit by: Maria H. Dotson RS date 11/9/2000 Operation Permit by: Maria H. Dotson RS date 7/18/2001

Authorization to Construct by: Maria H. Dotson RS date 11/9/2000 Existing System Inspection by: date

HEALTH DEPT. COPY: WHITE OWNER COPY (FINAL): YELLOW OWNER COPY (INITIAL): PINK