IREDELL COUNTY HEALTH DEPARTMENT

STATESVILLE 704-878-5305 MOORESVILLE 704-664-5281

IMPROVEMENT PERMIT / AUTHORIZATION TO CONSTRUCT / OPERATION PERMIT / EXISTING SYSTEM INSPECTION

$175

PERMIT# 078522 PIN# 4625941684 (pt-) 4626-81-9577 DATE May 19, '99

OWNER OR CONTRACTOR Crescent Resources Inc. / The Boaton Norman PHONE: Business 660-1185 Home

ADDRESS 2214 Brawley Sch Rd. Mooresville

LOCATION Brawley Sch Rd. TL Great Point DR. TL Wild Harbor Road TL Atlantic Way TR Breakwater Ct.

SUBDIVISION The Point BLOCK / SECTION III LOT 319 LOT AREA 32,332 ft² SITE CLASS. PS DESIGN FLOW 480gpd L.T.A.R. .25

Septic Tank: 1500 Gallons; STB 338 Date 7/14/00

Pump Tank: 1000 Gallons; PT 283 Date 3/14/00

Pump Make: MYERS Model ME50-3-22 Serial No.

Nitrification Field: No Fields 1 Square Feet 1440 Linear Feet 480

No Lines 6@80' Trench Width 36" Max Trench Bottom Depth 36" Gravel Depth NA

☑ New System ☐ Repair System Type: I, II, (III) IV, V, VI

System Description: PM INNOVATIVE -25% Reduction

Repair System Description: LP PANEL Block

Maintenance Agreement Required: ☐ Yes ☑ No

☑ House/Mod. Home No. Bedrooms 4

☐ Mobile Home No. Bathrooms 4

☐ Business No. Employees

☐ Other

☐ Slab ☑ Crawl Space ☐ Basement w/plumbing ☐ Basement wo/plumbing

Water Supply: ☐ Individual ☑ Public ☑ Community

Comments:/Conditions:

P/W


Breakwater Court

* ONE INSPECTION PORT PER LATERAL.


4/5/00 PI Dan reviewed, essentially complies with IP information - MWS.

Comments:/Conditions: 22 Flow installed.

INITIAL SITE SKETCH 1"=50'

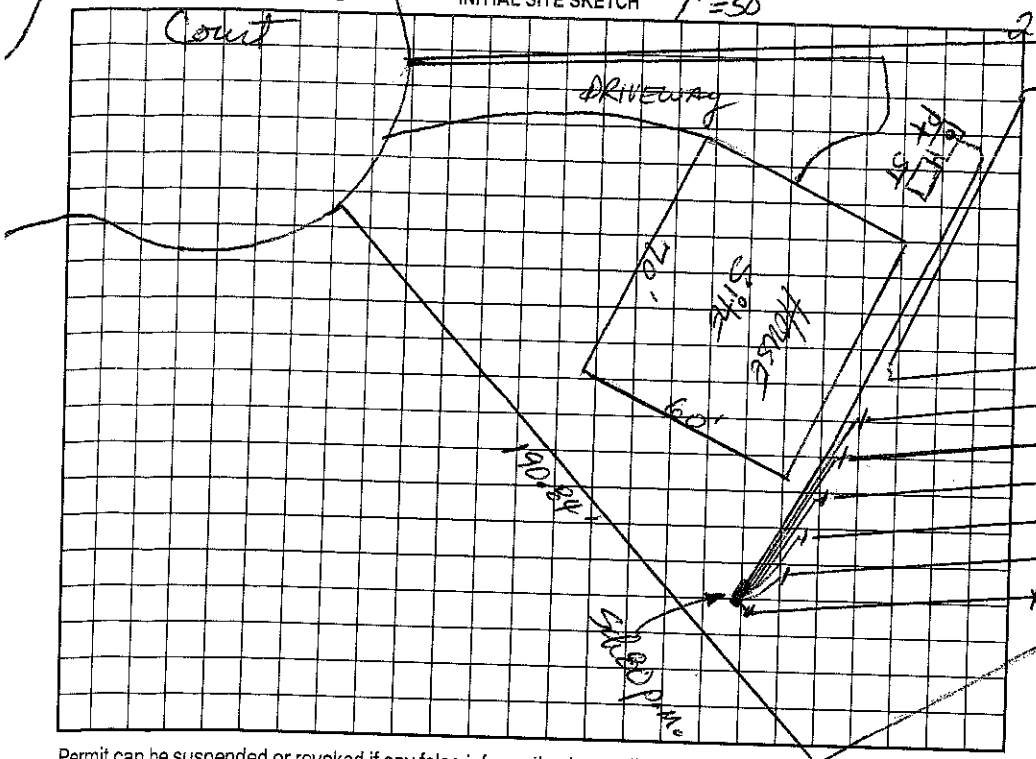

AS BUILT SKETCH

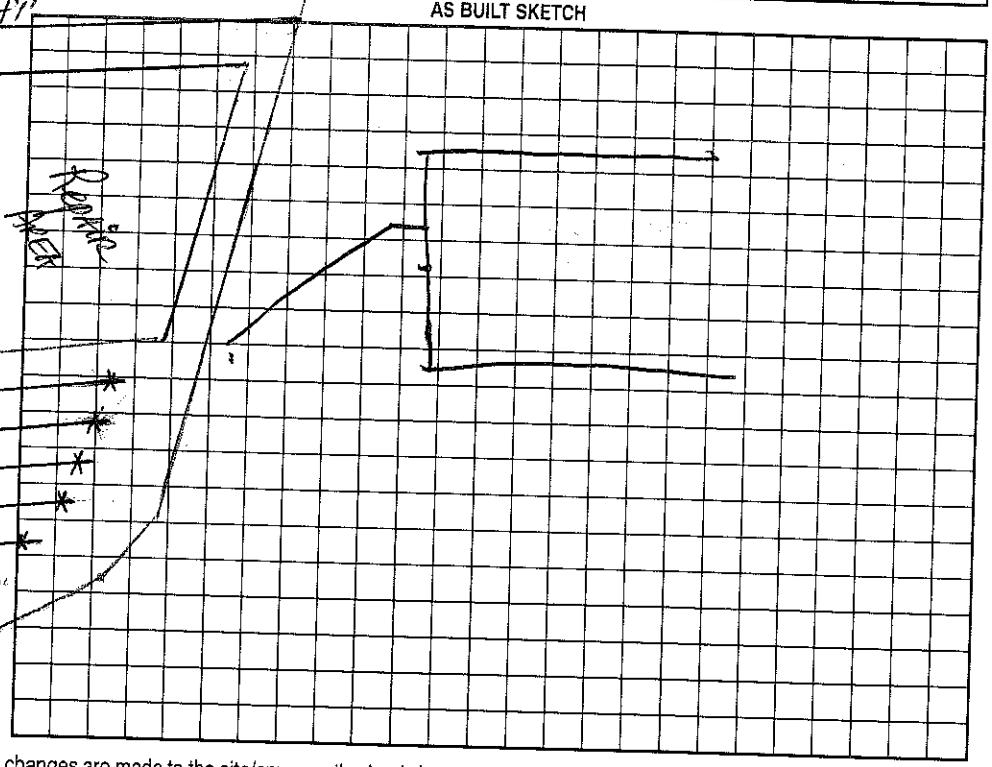

Permit can be suspended or revoked if any false information is supplied toward securing the permit/any unauthorized changes are made to the site/any unauthorized changes are made in the installation of the system. Improvement Permit with plat valid without expiration. Improvement Permit with site plan valid for sixty months. Authorization to Construct is valid for a period equal to that of Improvement Permit – not to exceed sixty months.

Signed: _____ date 6-9-99

Improvement Permit by: _____ date 5-1999

Authorization to Construct by: Wesley Sparks RS. date 4/5/00.

Installed by: R+H Inc.

Operation Permit by: _____ RS. date 11/13/2000

Existing System Inspection by: _____ date _____

HEALTH DEPT. COPY: WHITE OWNER COPY (FINAL): YELLOW OWNER COPY (INITIAL): PINK