# IREDELL COUNTY HEALTH DEPARTMENT

STATESVILLE 704-878-5305 MOORESVILLE 704-664-5281

## IMPROVEMENT PERMIT / AUTHORIZATION TO CONSTRUCT / OPERATION PERMIT / EXISTING SYSTEM INSPECTION

PERMIT# 152297 PIN# 4626822210 DATE 8/20/08

OWNER OR APPLICANT Tom Stevenson PHONE: Business 660-6638 Home

ADDRESS 570 Williamson Rd Ste E Mooresville, NC 28115

LOCATION 221 Wild Harbor Brawley School Rd TL Great Point TL Wild Harbor on left

SUBDIVISION The Point BLOCK / SECTION 3 LOT 353 LOT AREA 1.25 Acre SITE CLASS. PS DESIGN FLOW 480gpd L.T.A.R. .3

Septic Tank: Exist Gallons; STB Date

Pump Tank: Gallons; PT Date

Pump Make: Model Serial No.

Nitrification Field: No Fields 1 Exist Square Feet 1200' Linear Feet 400'

No Lines 5 Trench Width 36" Max Trench Bottom Depth 36"

☐ New System ☐ Repair ☐ Expansion System Type: I ☒ II ☐ III ☐ IV ☐ V ☐ VI (Existing)

System Description: Pump - PM - 25% Reduct

Repair System Description: Pump-PM 25% Reduct

Maintenance Agreement Required: ☐ Yes ☒ No

Gravel Depth N/A ☐ Gravity ☒ Pressure ☐ Slab ☐ Crawl Space ☒ Basement w/plumbing ☐ Basement wo/plumbing

☒ House/Mod. Home No. Bedrooms 4

☐ Mobile Home No. Persons

☐ Business No. Employees


☐ Other

Water Supply: ☐ Individual ☒ Public ☒ Community


Comments:/Conditions: Note: Keep Pool "Cut" at least 15Ft From tanks & Drain lines. Leave room For Supply line btw patio/house & pool Keep Supply line 10ft From Pool Cut

Comments:/Conditions: Solid pipe 1st part of last line < 15Ft from Cut & add to end of line 11/18/08 Supply line 5ft off patio

INITIAL SITE SKETCH

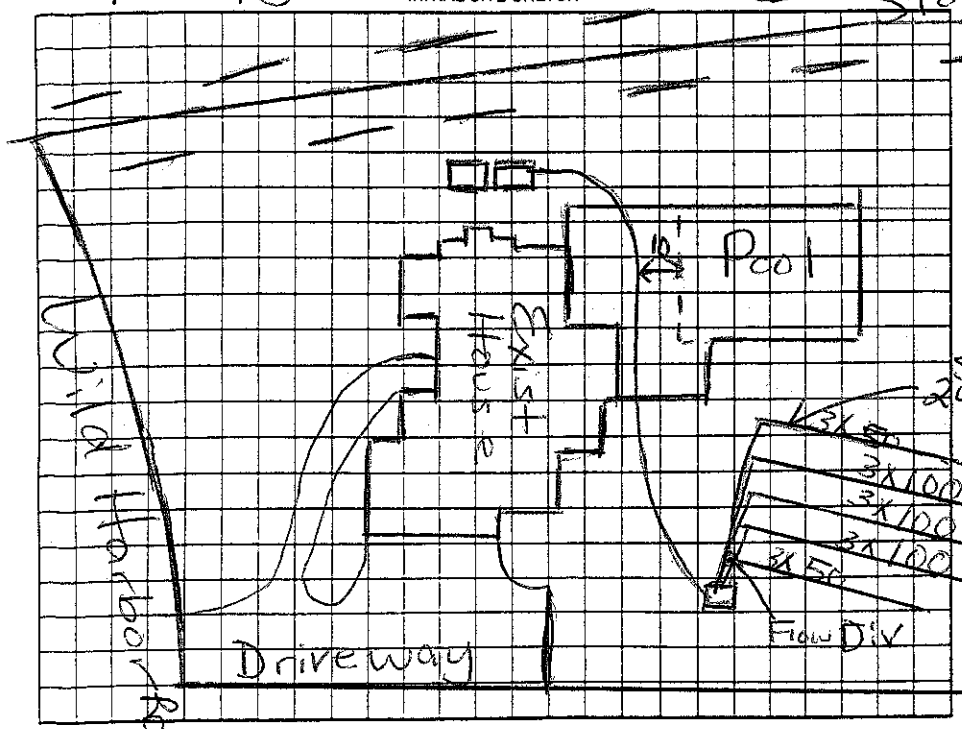


AS BUILT SKETCH

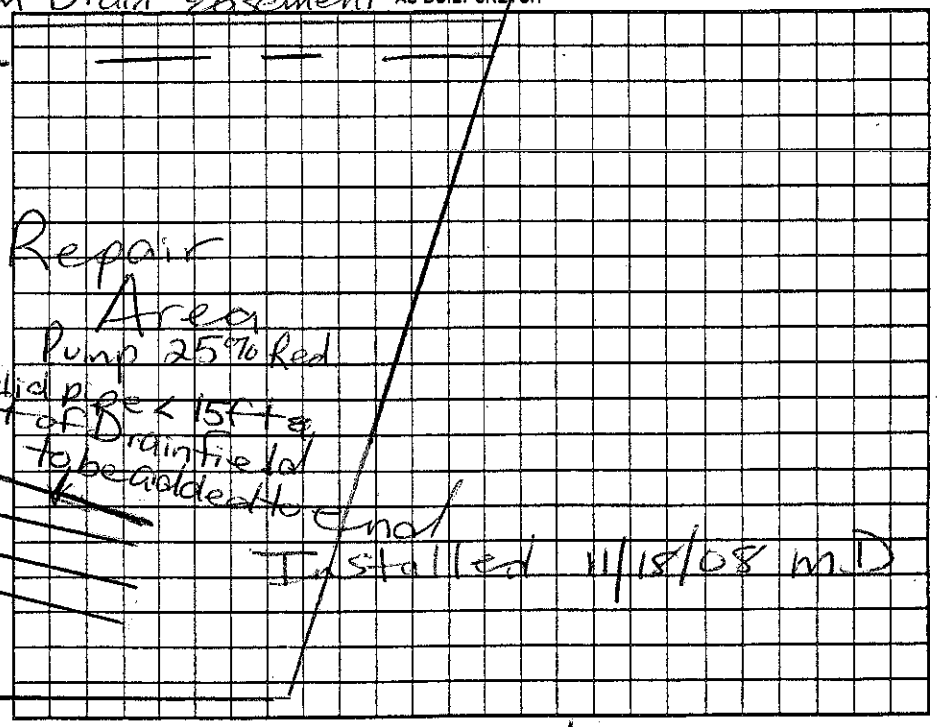


Permit can be suspended or revoked if any false information is supplied toward securing the permit/any unauthorized changes are made to the site/any unauthorized changes are made in the installation of the system. Improvement Permit with plat valid without expiration ☐ Improvement Permit with site plan valid for sixty months ☐ Authorization to Construct is valid for a period equal to that of Improvement Permit – not to exceed sixty months.

Signed Tom Stevenson date 8/22/08

Improvement Permit by: Maria H. Dolan RS date 8/21/08

Authorization to Construct by: Maria H. Dolan RS date 8/21/08

Installed by: Ralph Dolan 11/18/08

Operation Permit by: Maria H. Dolan date

Existing System Inspection by: date

HEALTH DEPT. COPY: WHITE OWNER COPY (FINAL): YELLOW OWNER COPY (INITIAL): PINK