IREDELL COUNTY HEALTH DEPARTMENT

STATESVILLE 704-878-5305 MOORESVILLE 704-664-5281

IMPROVEMENT PERMIT / AUTHORIZATION TO CONSTRUCT / OPERATION PERMIT / EXISTING SYSTEM INSPECTION

is Correct

$125

PERMIT# 01865 PIN# 4625944684 (pt) 4626823189 DATE June 8, '99

OWNER OR CONTRACTOR Crescent Resources Inc. / The Point on Norman PHONE: Business 660-1185 Home

ADDRESS 2214 Kearney School Rd. Mooresville

LOCATION Kearney Sch Rd. TL Great Point Drive TL Wild Harbor Rd. on left

SUBDIVISION The Point BLOCK / SECTION III LOT 352 LOT AREA 42,338 sf SITE CLASS. PS DESIGN FLOW 480gpd L.T.A.R. = 3

Septic Tank: 1000 + 1500 Gallons; STB 338 Date 7-9-04

Pump Tank: 1000 Gallons; PT 283 Date 7-16-04

Pump Make: Gould's Model WE0312MC Serial No.

Nitrification Field: No Fields Square Feet 1200 Linear Feet 400

No Lines 4@100' Trench Width 36" Max Trench Bottom Depth 36" Gravel Depth N/A

☑ New System ☐ Repair System Type: I, II, III, IV, V, VI

System Description: PM - INNOVATIVE -25% Reduction

Repair System Description: LPP Level Block

Maintenance Agreement Required: ☐ Yes ☑ No

☑ House/Mod. Home ☐ Mobile Home ☐ Business ☐ Other

No. Bedrooms 4 No. Bathrooms 4 No. Employees

☑ Slab ☑ Crawl Space ☐ Basement w/plumbing ☐ Basement wo/plumbing


Water Supply: ☐ Individual ☑ Public ☐ Community

Comments:/Conditions: * ONE INSPECTION PER LATERAL.


Comments:/Conditions: Checked tanks & lines @ 8/19/04

1"=50'

INITIAL SITE SKETCH

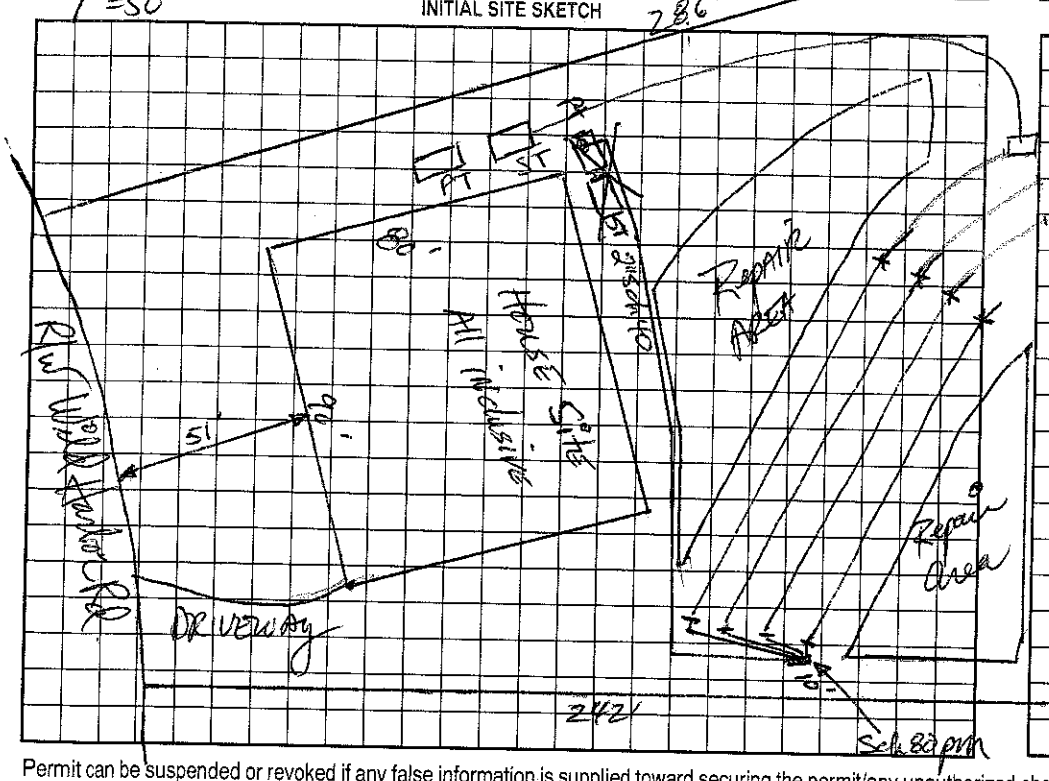

AS BUILT SKETCH

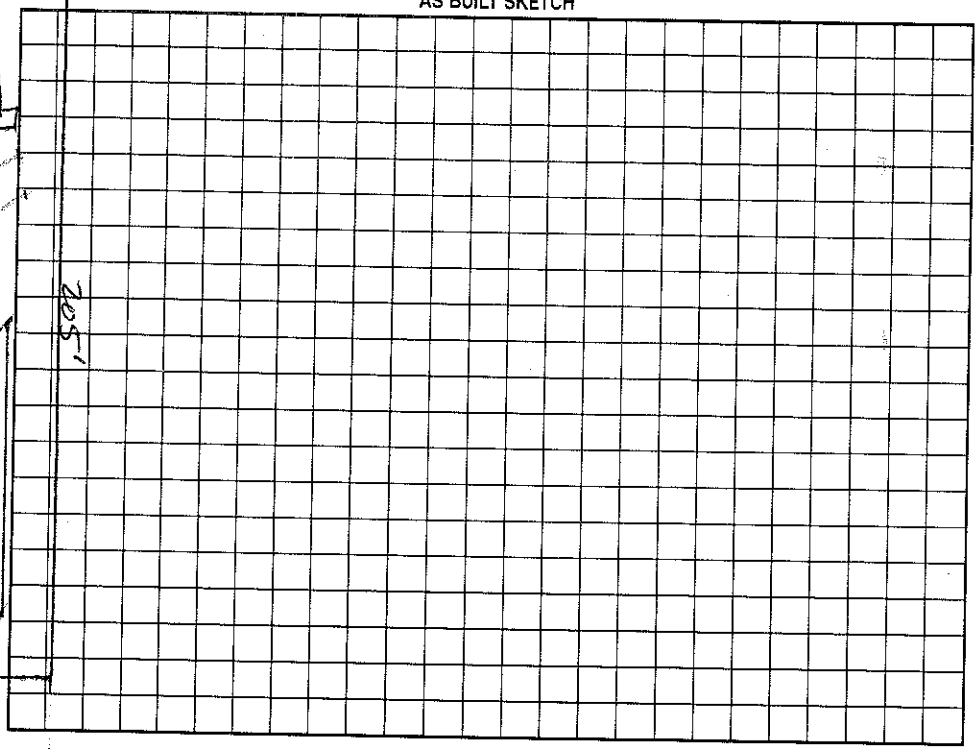

Permit can be suspended or revoked if any false information is supplied toward securing the permit/any unauthorized changes are made to the site/any unauthorized changes are made in the installation of the system. Improvement Permit with plat valid without expiration. Improvement Permit with site plan valid for sixty months. Authorization to Construct is valid for a period equal to that of Improvement Permit – not to exceed sixty months.

Signed: date 6-9-99

Improvement Permit by: date 6-8-99

Authorization to Construct by: RS date 2/12/04

Installed by: R & H RS.

Operation Permit by: Mark Dobson date 11/16/04

Existing System Inspection by: date

HEALTH DEPT. COPY: WHITE OWNER COPY (FINAL): YELLOW OWNER COPY (INITIAL): PINK