IREDELL COUNTY HEALTH DEPARTMENT

STATESVILLE 704-878-5305 MOORESVILLE [redacted]

IMPROVEMENT PERMIT / AUTHORIZATION TO CONSTRUCT / OPERATION PERMIT / EXISTING SYSTEM INSPECTION

PERMIT # 158213 PIN # 4626834416 DATE 9-24-2009 Suzi

OWNER or APPLICANT 4 Paws / William Stewart PHONE: Business Bill 704-564-5380 Home: 704 929-2304

OWNER or APPLICANT ADDRESS 110 Woodthrush Ln Mooresville, NC 28117

LOCATION / DIRECTIONS Brawley School Rd on right next to Uncle Milf's Lk Norman Tavern #1464

SUBDIVISION 1012 BLOCK / SECTION LOT # LOT AREA DESIGN FLOW 150gpd L.T.A.R. .3


ST1 ST2

Septic Tank	1000 Gallons: STB [illegible]	Date 6-23-05	☒ New System ☐ Repair ☐ Expansion System	Type I (II) III IV V VI	☐ Residence	No. Bedrooms	Water Supply
~~Pump Tank~~	1000 Gallons: PT 1012	Date 6-23-05	System Description: Gravity - Conventional		☐ Business	No. Persons	☒ Private
Pump Make	Model	Serial #	Repair System Description: Lot/Tract documented 1981		☒ Other	No. Employees 2	☐ Public
Nitrification Field No Fields 1	No Lines 4	Linear Feet 160 ft	Maintenance Agreement Required ☐ YES ☒ NO		☐ Slab	☒ Crawl Space	☐ Community
Trench Width 36"	Max. Trench Bottom Depth 30"	Gravel Depth 12"	☒ GRAVITY ☐ PRESSURE		☐ Basement w/plumbing	☐ Basement w/o plumbing	

Comments / Conditions 1) Screens to catch hair & other solids shall be placed in drains. Soaps & shampoos shall be biodegradable. No Synthetic pesticides or insecticides can be discharged into system.

Comments / Conditions Note: 10 dogs a day @ 10 gal each + 2 employees @ 25 gal each = 150 gpd MSDS sheets for each chemical used shall be given to H.D.

INITIAL SITE SKETCH

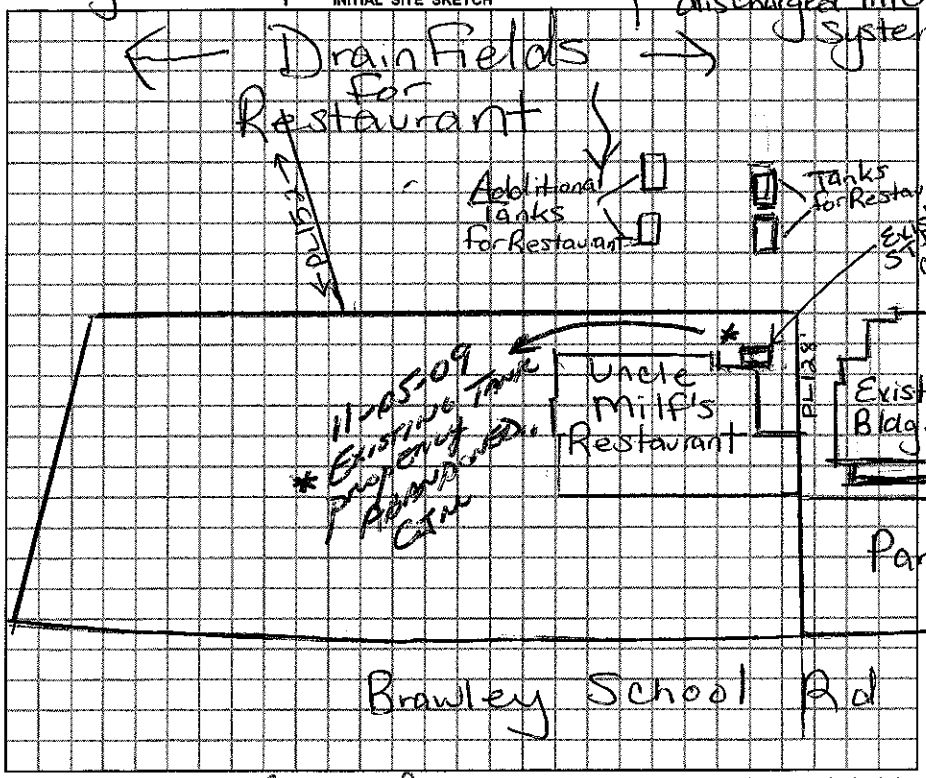

AS BUILT SKETCH

Plastic Chamber or polystyrene may be used but no reduction will be given.

Stay 10ft from PL

2 Septic tanks with access openings extended to finish grade. 1st Septic tank shall receive only process wastewater from Dog grooming operations (no toilet wastewater) 2nd Septic tank shall receive effluent from 1st ST in addition to Sewage.

Install filter for animal hair on 1st ST. 2nd ST shall have an effluent filter

* Hair filter in 1st ST cleaned weekly.

Permit can be suspended or revoked if any false information is supplied toward securing the permit / any unauthorized changes are made to the site / any unauthorized changes are made in the installation of the system.

☐ *IMPROVEMENT PERMIT w/ plat valid without expiration.* ☐ *IMPROVEMENT PERMIT w / site plan valid for 60 mos.* ☐ *AUTHORIZATION TO CONSTRUCT valid for period equal to IMPROVEMENT PERMIT-not to exceed 60 mo.*

Owner / Applicant Signature: [signature] Date 9/25/09

Improvement Permit by: Maria Hall-Tolson RS Date 9/25/09

Authorzation to Construct by: Maria Hall-Tolson RS Date 9/25/09

YOU SHOULD CONTACT A LOCATOR SERVICE PRIOR TO ANY EXCAVATION.

Installed by: Steve Jordon

Operation Permit by: Maria Hall-Tolson RS Date: 11/4/09

Existing System Inspected by: Date:

WHITE COPY Environmental Health YELLOW COPY (Final) Owner / Applicant PINK COPY (Initial) Owner / Applicant