IREDELL COUNTY HEALTH DEPARTMENT

Statesville Office (704) 878-5305 Mooresville Office (704) 660-3625 PERMIT # Z10357

ALP 1130

IMPROVEMENT PERMIT / AUTHORIZATION TO CONSTRUCT / OPERATION PERMIT / EXISTING SYSTEM

PIN # 4626-84-0394

APPLICANT: Rollans Soil & Env. Services APPLICANT ADDRESS: Po Box 832 Mville

SITE ADDRESS: 102 Dunn Ross Ct. - Mresv. Shane Duntery PHONE: 704-746-5046 ALT. PHONE:

SITE DIRECTIONS: Agnew, TR Magnolia, TR Dunn Ross, on L

SUBDIVISION: The Farms SECTION: 1 LOT # 48 LOT AREA: 2.42 AC DESIGN FLOW: 600 L.T.A.R.: .275

Septic Tank 1500 (gal)	STB 444	Date 6/4/16	☒ New System ☐ Repair ☐ Expansion	System Type: I II III (IV) V VI	☒ Residence	No. Bedrooms 3	Water Supply
Pump Tank 1500 (gal)	PT 477	Date 10/12/16	System Description: LP - Panel Block		☐ Business	No. Persons	☐ Private
Pump Make [illegible]	Model [illegible]	Serial #	Repair System Description: Pretreat Drip		☐ Other	No. Employees	☐ Public
# Nitrification Fields 1	# Lines 6	Linear Ft: 365'	Maintenance Agreement Required: ☒ YES ☐ NO		☐ Slab	☒ Crawl Space	☒ Community
Trench Width 24"	Max. Trench Bottom Depth 30-34"	Gravel Depth —	☐ GRAVITY ☒ PRESSURE		☐ Basement w/plumbing	☐ Basement w/o plumbing	

Comments / Conditions:

11/13/15 Reviewed Floor plans, house slightly larger than shown on Septic plan but still should work

INITIAL SITE SKETCH

See Plan From Rollans Soil & Environmental Services

AS BUILT SKETCH

12/5/16 Water line removed
Note: part of Septic line uncovered by plumber to put in water line.

39
44
66
79
110
88

10" [illegible]

	Date	Initials
Drain Lines Checked	11/16	WS
Tanks Checked	11/16	WS
Pressure Manifold or Valve Box Checked	11/16	WS
Pressure Head Set	12/5/16	MD
Electrical Checked		
Floats Set		
Alarm Checked		
Maintenance Contract Y / N		
Comments: 12/5 water line not left from Septic Supply line		

WATER LINE IN SAME [illegible]

Permit can be suspended or revoked if any false information is supplied toward securing the permit / any unauthorized changes are made to the site / any unauthorized changes are made in the installation of the system. CONTACT A LOCATOR SERVICE PRIOR TO ANY EXCAVATION

☐ **IMPROVEMENT PERMIT** *with plat valid without expiration.* ☒ **IMPROVEMENT PERMIT** *with site plan valid for 60 mos.* ☐ **AUTHORIZATION TO CONSTRUCT** *valid for period equal to IMPROVEMENT PERMIT--not to exceed 60 mo.*


Owner / Applicant Signature: Date: 11/9/15 Installed by: Richard Alexander

IMPROVEMENT PERMIT by: APPROVED Date: NOV 03 2015 OPERATION PERMIT by: Maria Dotson RS Date: 12/5/16

AUTHORIZATION TO CONSTRUCT by: Maria Dotson RS Date: 11/13/15 Existing System Inspected by: Date:

Health Dept. Copy - WHITE Applicant (Final Approval) - YELLOW Applicant (Conditional Approval) - PINK

APPROVED NOV 0 3 2015

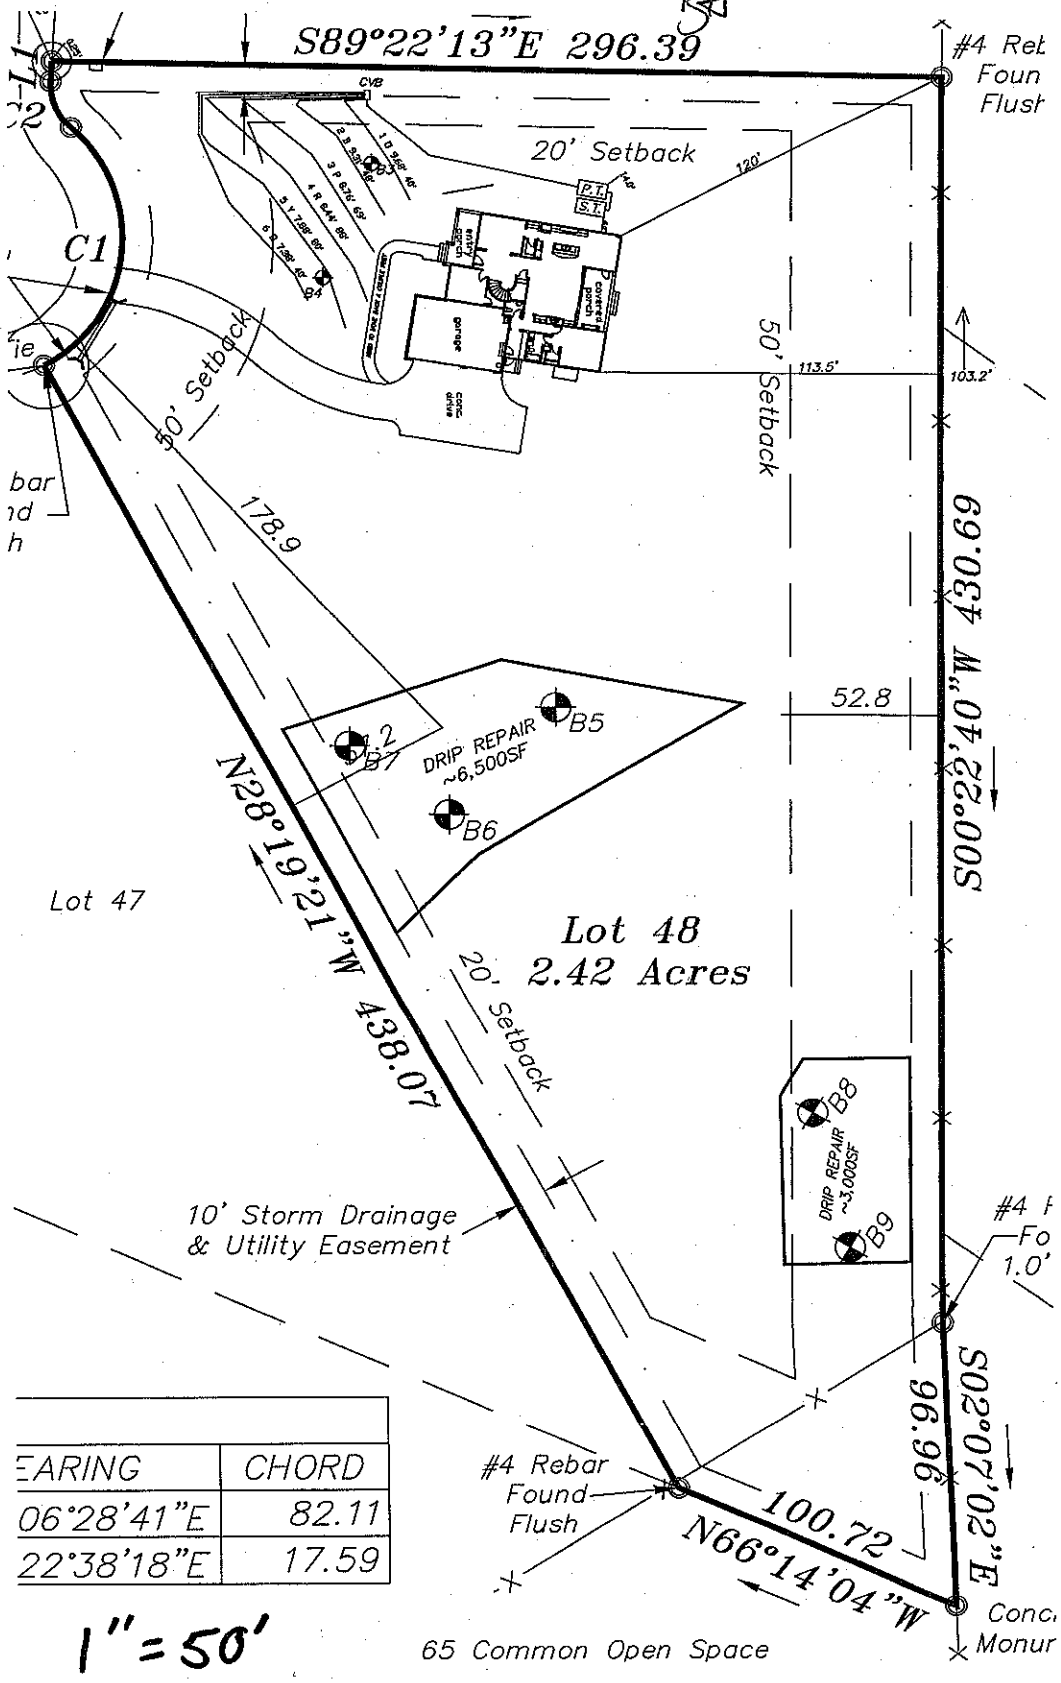

EARING	CHORD
06°28'41"E	82.11
22°38'18"E	17.59

1" = 50'