IREDELL COUNTY HEALTH DEPARTMENT

STATESVILLE 704-878-5305 MOORESVILLE 704-664-5281

IMPROVEMENT PERMIT / AUTHORIZATION TO CONSTRUCT / OPERATION PERMIT / EXISTING SYSTEM INSPECTION

PERMIT# 112022 PIN# ~~4726-63-7315-49~~ 4626840567 DATE Nov. 9, 04

OWNER OR CONTRACTOR Greg Robbins Custom Homes PHONE: Business 336-766-6966 Home

ADDRESS PO Box 30220 Winston-Salem, NC. 27130

LOCATION 1100 TR South Fork (R) Agnew TR Caldwell Lk TR Magnolia Farms to end on Dunn Rock Ct.

SUBDIVISION Farms BLOCK / SECTION 1 LOT 49 LOT AREA 1.006 SITE CLASS. PS DESIGN FLOW 480 L.T.A.R. .25

Septic Tank: ~~1500~~ 1000 Gallons; STB 338 Date 9/26/04

Pump Tank: 1000 Gallons; PT 283 Date 10/4/04

Pump Make: Gollads Model VED03/2 HH Serial No. D0458581

Nitrification Field: No Fields 1 Square Feet 1440 Linear Feet 480

No Lines 4 @ 120' Trench Width 3' Max Trench Bottom Depth 20" Gravel Depth No

☐ New System ☐ Repair System Type: I, II, III, IV, V, VI

System Description: Pump Manifold - 25% Reduced

Repair System Description: 25% Reduced

Maintenance Agreement Required: ☐ Yes ☒ No

☒ House/Mod. Home No. Bedrooms 4

☐ Mobile Home No. Bathrooms 4

☐ Business No. Employees

☐ Other


☐ Slab ☒ Crawl Space ☐ Basement w/plumbing ☐ Basement wo/plumbing

Water Supply: ☐ Individual ☐ Public ☒ Community


Comments:/Conditions: Installer note: Maximum trench depth. 20 inches.

Comments:/Conditions: Tanks, Lines, EZ Flow installed

INITIAL SITE SKETCH

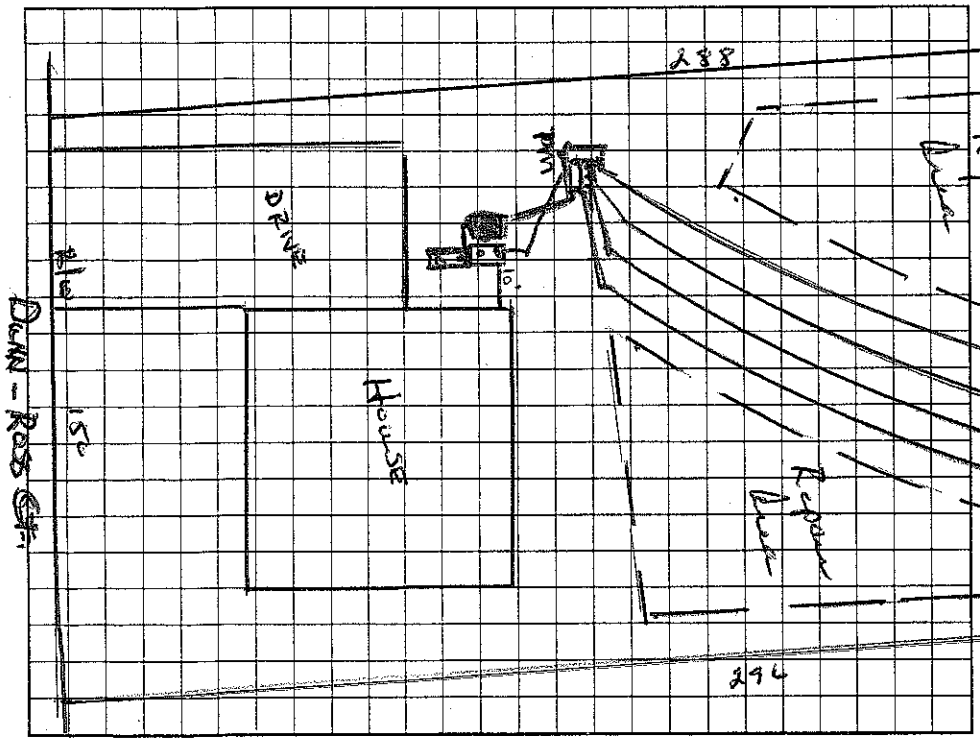

AS BUILT SKETCH

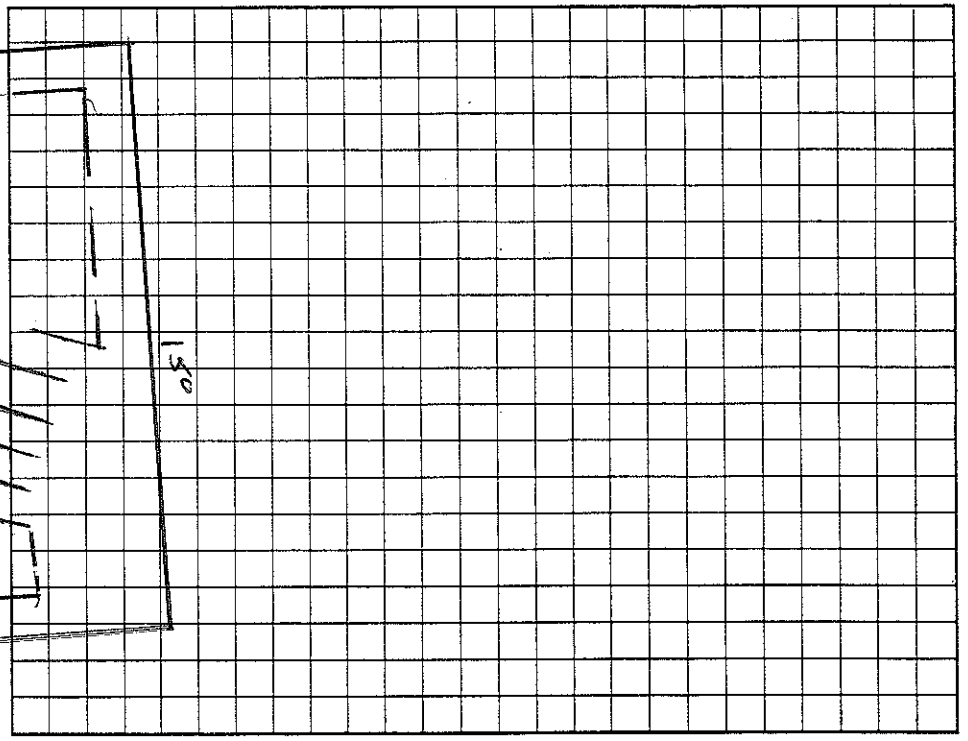

Permit can be suspended or revoked if any false information is supplied toward securing the permit/any unauthorized changes are made to the site/any unauthorized changes are made in the installation of the system. Improvement Permit with plat valid without expiration. Improvement Permit with site plan valid for sixty months. Authorization to Construct is valid for a period equal to that of Improvement Permit – not to exceed sixty months.

Signed: * [signature] date 11/10/04 Installed by: Kevin Hallman

Improvement Permit by: Wesley Sparks R.S. date 11/9/04 Operation Permit by: Wesley Sparks R.S. date 1/13/05

Authorization to Construct by: Wesley Sparks R.S. date 11/9/04 Existing System Inspection by: date

HEALTH DEPT. COPY: WHITE OWNER COPY (FINAL): YELLOW OWNER COPY (INITIAL): PINK