(2:30) ale 4626844868

IREDELL COUNTY HEALTH DEPARTMENT

Const. Auth. STATESVILLE 704-878-5305 MOORESVILLE 704-664-5281

IMPROVEMENT PERMIT / ~~CERTIFICATE OF COMPLETION~~ / OPERATION PERMIT / EXISTING SYSTEM INSPECTION

PROPERTY DESCRIPTION NO. 23136 DATE March 13, 96 TAX MAP NO. part of 2FA3

OWNER OR CONTRACTOR Wayne Frye Watershed: ☑ Yes ☐ No

ADDRESS 4110 Hwy 158, Advance, NC 27006 PHONE: Business _____ Home (910) 418-3393

LOCATION Brawley School Road TR McKendree ¼ mile on left

SUBDIVISION McKendree Place BLOCK / SECTION _____ LOT 4 LOT AREA 30,000 ft² SITE CLASS PS pm. 1956 DESIGN FLOW 480 gpd L.T.A.R. .3

Septic Tank: 1500 Gallons; STB 964 Date 9/1/94

Pump Tank: _____ Gallons; PT _____ Date _____

Pump Make: _____ Model _____ Serial No. _____

Nitrification Field: No Fields 1 Square Feet 1620 Linear Feet 540

No Lines 4@135' Trench Width 36" Max Trench Bottom Depth 36" Gravel Depth 12"

☑ New System ☐ Repair System Type: I ☑ II III IV V VI

System Description: gravity conventional

Repair System Description: gravity chambered

Maintenance Agreement Required: ☐ Yes ☑ No

☐ House/Mod. Home No. Bedrooms 4

☐ Mobile Home No. Bathrooms 4

☐ Business No. Employees _____

☑ Other Duplex Apt

☐ Slab ☐ Crawl Space ☐ Basement w/plumbing ☐ Basement wo/plumbing


Water Supply: ☑ Individual ☐ Community ☐ Public

Comments:

Comments: Improvements Permit only

1"=60'

INITIAL SITE SKETCH

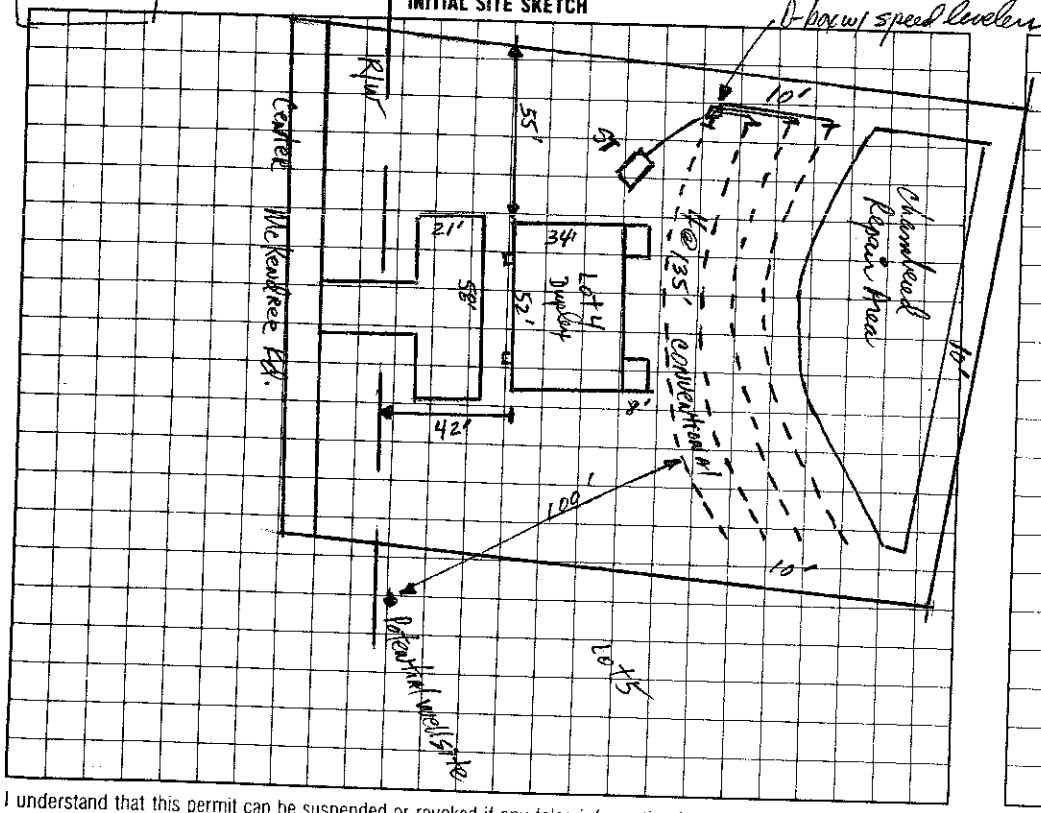

AS BUILT SKETCH

Substantially as shown

I understand that this permit can be suspended or revoked if any false information is supplied toward securing the permit/any unauthorized changes are made to the site/any unauthorized changes are made in the installation of the system.

Signed: _____

Improvement Permit by: Howard E. Hamm RS date 3-13-96

~~Authorization~~ ~~Existing System Inspection~~ by: D. Hamm RS date 7-2-96

to construct

Installed by: DONALD LAKEY

Certificate of Completion by: _____ date _____

Operation Permit by: C. Ray Hamm date 4/11/97

HEALTH DEPT. COPY: WHITE INSPECTION COPY (FINAL): GREEN OWNER COPY (FINAL): YELLOW INSPECTION COPY (INITIAL): PINK OWNER COPY (INITIAL): GOLD