4626841680l 3:30 - 4:00

IREDELL COUNTY HEALTH DEPARTMENT

Const. Auth. STATESVILLE 704-878-5305 MOORESVILLE 704-664-5281

IMPROVEMENT PERMIT / ~~CERTIFICATE OF COMPLETION~~ / OPERATION PERMIT / EXISTING SYSTEM INSPECTIO

PROPERTY DESCRIPTION NO. 23135 DATE March 12, '96 TAX MAP NO. part of 2FA3 Watershed: ☑ Yes ☐ No

OWNER OR CONTRACTOR Wayne Frye PHONE: Business ____ Home (910) 418-3393

ADDRESS 4110 Hwy 158 Advance, NC 27006

LOCATION Brantley Ferry Rd. TR McKendree ~1/8 mile on left

SUBDIVISION McKendree Place BLOCK / SECTION ____ LOT 3 LOT AREA 30,000 ft² SITE CLASS PSpa.1956 DESIGN FLOW 480gpd L.T.A.R. .3

Septic Tank: 1500 Gallons; STB 964 Date 12/4/96

Pump Tank: ____ Gallons; PT ____ Date ____

Pump Make: ____ Model ____ Serial No. ____

Nitrification Field: No Fields 2 Square Feet 1620 Linear Feet 540

No Lines 3+2 Trench Width 36" Max Trench Bottom Depth 36" Gravel Depth ____

☑ New System ☐ Repair System Type: I. II. III. IV. V. VI

System Description: gravity conventional

Repair System Description: ~~gravity~~ grav. chambered, etc

Maintenance Agreement Required: ☐ Yes ☑ No

☐ House/Mod. Home No. Bedrooms 4

☐ Mobile Home No. Bathrooms 4

☐ Business No. Employees ____

☑ Other Duplex Apt.

☐ Slab ☑ Crawl Space ☐ Basement w/plumbing ☐ Basement wo/plumbing

Water Supply: ~~Individual~~ ☐ Individual ☐ Community ☐ Public

Comments:

Potential well site

Upper subfield

1 ea @ 85', 90', 95'


4 D-box w/speed levelers

Comments:

~~Manufactured Home~~

1" = 60'

INITIAL SITE SKETCH

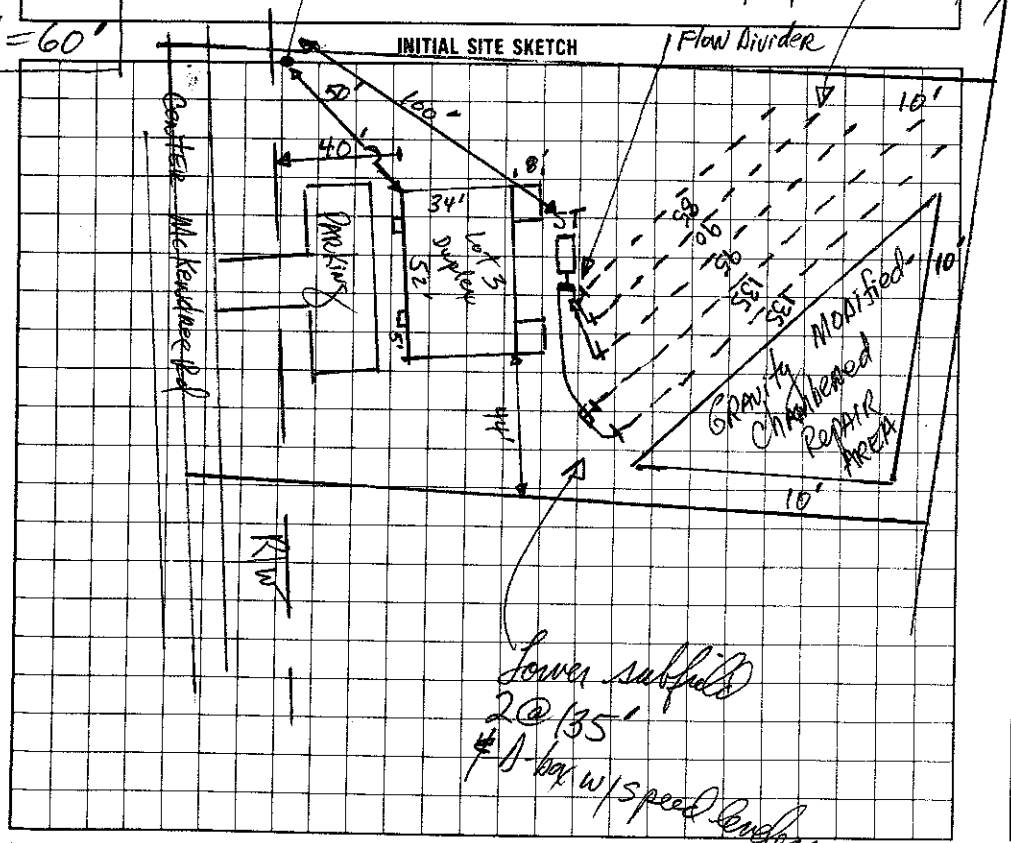

AS BUILT SKETCH

INSTALLED AS SHOWN ON SKETCH

I understand that this permit can be suspended or revoked if any false information is supplied toward securing the permit/any unauthorized changes are made to the site/any unauthorized changes are made in the installation of the system.

Signed: [signature]

Improvement Permit by: [signature], RS date 3-12-96

~~Existing System Inspection by:~~ Authorization to construct [signature], RS date 7-2-96

Installed by: LAKEY BACKHOE SERVICE

Certificate of Completion by: ____ date ____

Operation Permit by: [signature] date 2/3/97

HEALTH DEPT. COPY: WHITE INSPECTION COPY (FINAL): GREEN OWNER COPY (FINAL): YELLOW INSPECTION COPY (INITIAL): PINK OWNER COPY (INITIAL): GOLD