4626847715

IREDELL COUNTY HEALTH DEPARTMENT

Auth Const. STATESVILLE 704-878-5305 MOORESVILLE 704-664-5281

IMPROVEMENT PERMIT / ~~CERTIFICATE OF COMPLETION~~ / OPERATION PERMIT / EXISTING SYSTEM INSPE.

PROPERTY DESCRIPTION NO. 23134 DATE March 12, '96 TAX MAP NO. part of 2FA3 Watershed: Yes

OWNER OR CONTRACTOR Wayne Frye PHONE: Business / Home (910) 418-3393

ADDRESS 410 Hwy 158, Advance NC 27006

LOCATION Brawley School Road TR McKendree ~ 1/10 mile on left

SUBDIVISION McKendree Place BLOCK / SECTION LOT 2 LOT AREA 30,000 ft² SITE CLASS. PS pa. 1996 DESIGN FLOW 480gpd L.T.A.R. .3

Septic Tank: 1500 Gallons; STB 10 Date 9/21/96

Pump Tank: Gallons; PT Date

Pump Make: Model Serial No.

Nitrification Field: No Fields 1 Square Feet 1200 Linear Feet 400

No Lines 4 Trench Width 36" Max Trench Bottom Depth 36"

☑ New System ☐ Repair System Type: I II (III) IV V VI

System Description: Gravity Chambered

Repair System Description: Gravity Chambered

Maintenance Agreement Required: ☐ Yes ☑ No

Gravel Depth NA

☐ House/Mod. Home ☐ Mobile Home ☐ Business ☑ Other Duplex Apt.

No. Bedrooms 4 No. Bathrooms 4 No. Employees

☐ Slab ☑ Crawl Space ☐ Basement w/plumbing ☐ Basement wo/plumbing


Water Supply: ☑ Individual ☐ Community ☐ Public

Comments: Well on Lot 1 (Existing 6" @ rear of lot) must be properly abandoned prior to issuance of O.P.

Comments: Improvements Permit Only

1" = 60'

INITIAL SITE SKETCH

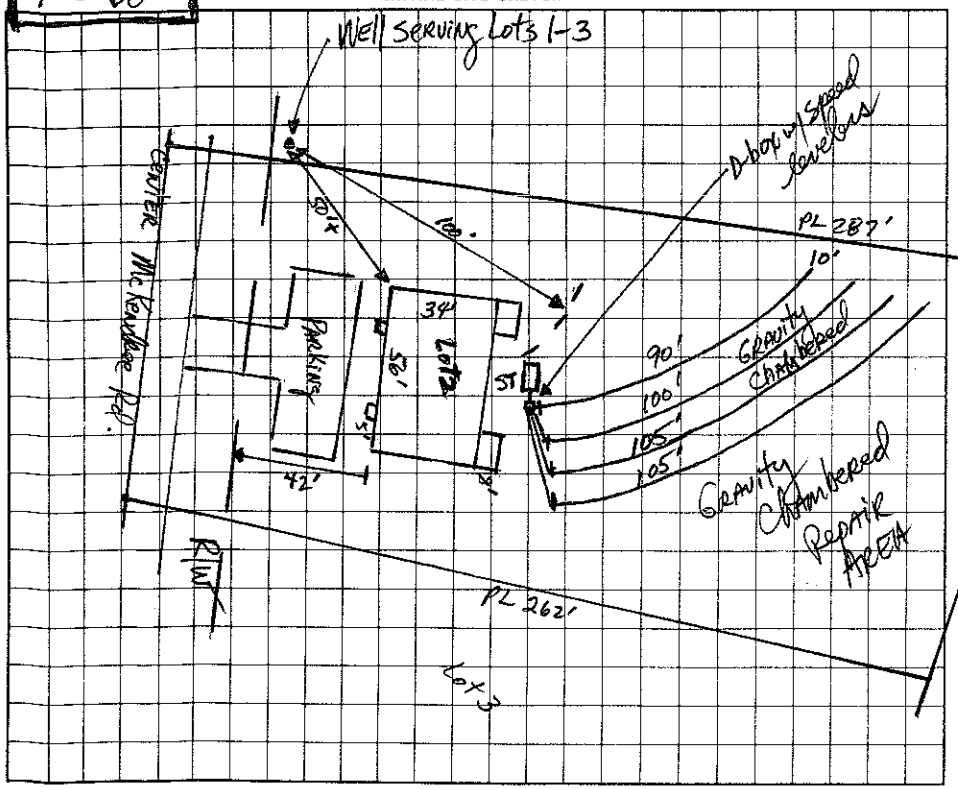

AS BUILT SKETCH

Installed as shown.

I understand that this permit can be suspended or revoked if any false information is supplied toward securing the permit/any unauthorized changes are made to the site/any unauthorized changes are made in the installation of the system

Signed [signature]

Improvement Permit by: David Stamper, RS date 3-12-96

~~Existing System Inspection by:~~ Authorization returned DR Hinson, RS date 7-2-96

Installed by: Lackey Backhoe Service

Certificate of Completion by: date

Operation Permit by: Wesley Sparks RS date 2/25/97

HEALTH DEPT. COPY: WHITE INSPECTION COPY (FINAL): GREEN OWNER COPY (FINAL): YELLOW INSPECTION COPY (INITIAL): PINK OWNER COPY (INITIAL): GOLD