IREDELL COUNTY HEALTH DEPARTMENT

Authorization to Construct PIN# 4626-85-0852

STATESVILLE 704-878-5305 MOORESVILLE 704-664-5281

IMPROVEMENT PERMIT / ~~CERTIFICATE OF COMPLETION~~ / OPERATION PERMIT / EXISTING SYSTEM INSPECTION

PROPERTY DESCRIPTION NO. 21474 DATE 10/17/95 TAX MAP NO. 2F 10 B 8+9 Watershed: X Yes ☐ No

OWNER OR CONTRACTOR RSMB Enterprises Inc. PHONE: Business 663-5592 Home

ADDRESS 634 E Center Ave Mooresville, NC. 28115

LOCATION Brawley Sch TR McKendree TR Camelot TR Ridgebrook lots on (L)

SUBDIVISION Brookridge Shores BLOCK / SECTION LOT 8+9 LOT AREA 1.1 Ac SITE CLASS. PS DESIGN FLOW 480 L.T.A.R. .3

Septic Tank: 1000 Gallons; STB 794 Date 3/25/96

Pump Tank: Gallons; PT Date

Pump Make: Model Serial No.

Nitrification Field: No Fields 1 Square Feet 1200 Linear Feet ~~300~~ (400)

No Lines 3 Trench Width 36" Max Trench Bottom Depth 32" Gravel Depth N/A

X New System ☐ Repair System Type: I, II, (III), IV, V, VI

System Description: Gravity infiltrator

Repair System Description:

Maintenance Agreement Required: ☐ Yes ☐ No

X House/Mod. Home No. Bedrooms 4

☐ Mobile Home No. Bathrooms 3

☐ Business No. Employees

☐ Other


☐ Slab ☐ Crawl Space X Basement w/plumbing ☐ Basement wo/plumbing

Water Supply: X Individual ☐ Community ☐ Public

Comments: ~~X~~ 25% reduction for infiltrator

Comments:

INITIAL SITE SKETCH

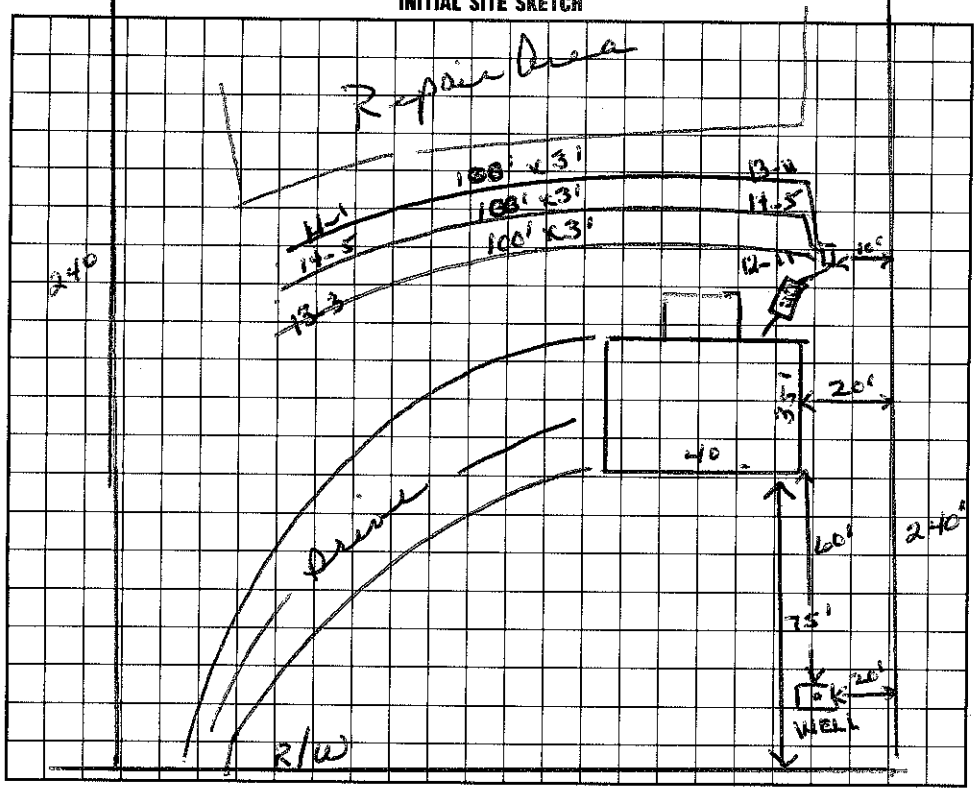

AS BUILT SKETCH

I understand that this permit can be suspended or revoked if any false information is supplied toward securing the permit/any unauthorized changes are made to the site/any unauthorized changes are made in the installation of the system.

Signed: Michael Ridgebrook RSMB Authorization to construct 5 yr. valid - Improvement time limit

Improvement Permit by: Wesley Sparks R.S. date 10/17/95

Authorization to Construct Wesley Sparks R.S. date 10/17/95

Existing System Inspection by: date

Installed by: Lawton Benton

Certificate of Completion by: date

Operation Permit by: Wesley Sparks R.S. date 6/7/96

HEALTH DEPT. COPY: WHITE INSPECTION COPY (FINAL): GREEN OWNER COPY (FINAL): YELLOW INSPECTION COPY (INITIAL): PINK OWNER COPY (INITIAL): GOLD