11:00 PAID $725

IREDELL COUNTY HEALTH DEPARTMENT

STATESVILLE 704-878-5305 MOORESVILLE 704-664-5281

IMPROVEMENT PERMIT / AUTHORIZATION TO CONSTRUCT / OPERATION PERMIT / EXISTING SYSTEM INSPECTION

PERMIT # 154575 PIN # 4626-85-1366 DATE 2-6-09

OWNER or APPLICANT ROBERT RIFFLE PHONE: Business 704-664-3695 Home:

OWNER or APPLICANT ADDRESS 359 BEATEN PATH RD MOORESVILLE NC. 28117

LOCATION / DIRECTIONS BSR, TR MCKENDREE, TR CARRIE, TR RIDGEBROOK C END

SUBDIVISION BROOKRIDGE SHORES BLOCK / SECTION LOT # 4 LOT AREA .18 AC DESIGN FLOW 360 L.T.A.R. .35

Septic Tank 1000 Gallons: STB 1007 Date 1-23-09
Pump Tank 1000 Gallons: PT 1006 Date 3-15-09
Pump Make ZOELLER Model 53-0002 Serial # .3HP
Nitrification Field No Fields 1 No Lines 3 Linear Feet 264'
Trench Width 36" Max. Trench Bottom Depth 36" Gravel Depth —


☒ New System ☐ Repair ☐ Expansion System Type I II III IV V VI
System Description: PM- 25%
Repair System Description: PM- 25%
Maintenance Agreement Required ☐ YES ☒ NO
☐ GRAVITY ☒ PRESSURE

☒ Residence No. Bedrooms 3
☐ Business No. Persons
☐ Other No. Employees
☐ Slab ☒ Crawl Space
☐ Basement w/plumbing ☐ Basement w/o plumbing

Water Supply: ☒ Private ☐ Public ☐ Community

Comments / Conditions 1) KEEP ALL PARTS OF SEPTIC MIN 10' FROM PROPERTY LINE & 15' FROM POOL

Comments / Conditions

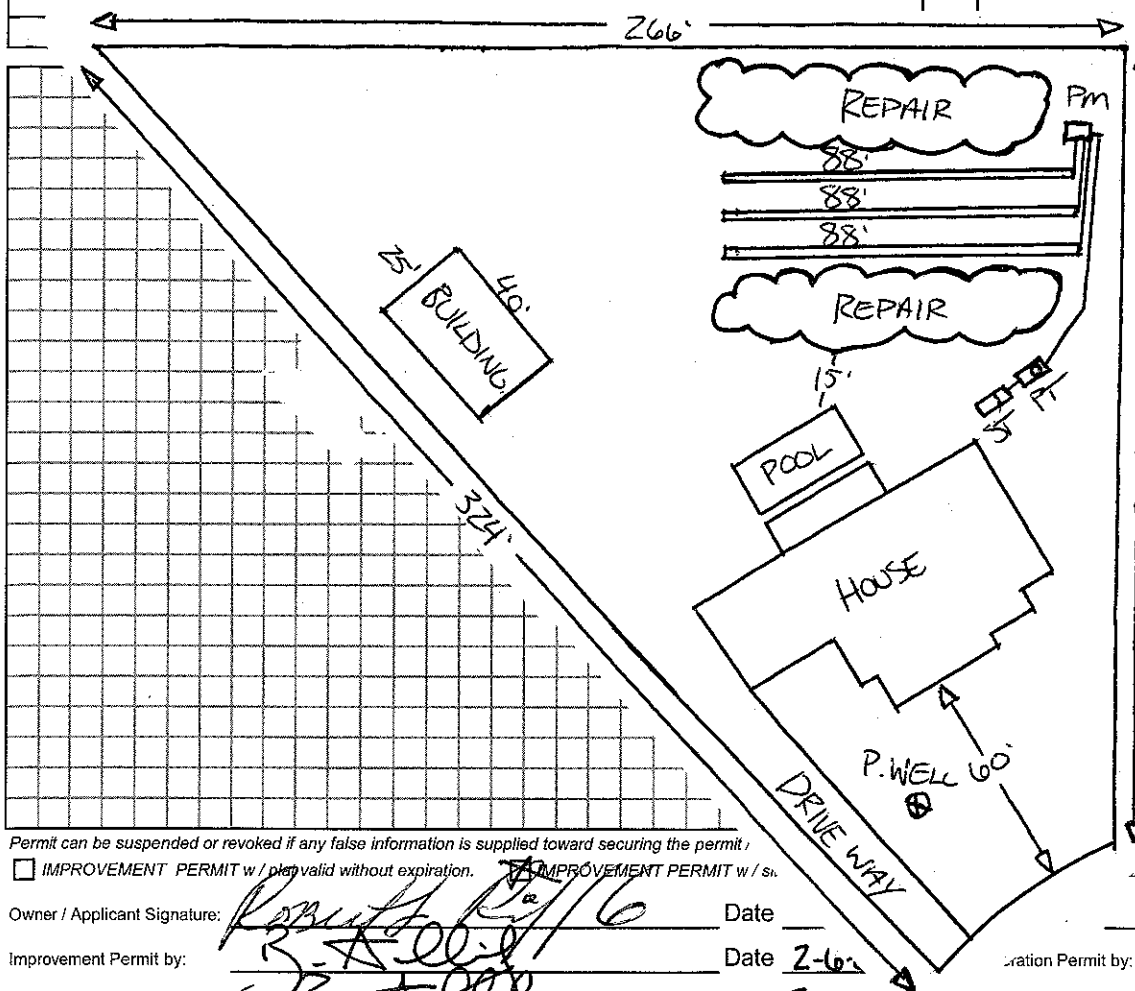

AS BUILT SKETCH

INSTALLED QUIK-4

18 CHAMBERS PER LINE

Permit can be suspended or revoked if any false information is supplied toward securing the permit / unauthorized changes are made in the installation of the system.

☐ *IMPROVEMENT PERMIT w / plan valid without expiration.* ☒ *IMPROVEMENT PERMIT w / si... ...ATION TO CONSTRUCT valid for period equal to IMPROVEMENT PERMIT-not to exceed 60 mo.*

Owner / Applicant Signature: [signature] Date

Improvement Permit by: [signature] Date 2-6-09

Authorization to Construct by: [signature] Date 2-6-09

...ration Permit by: [signature] KEVIN BOWERS RS Date: 5-13-09

Existing System Inspected by: Date:

YOU SHOULD CONTACT A LOCATOR SERVICE PRIOR TO ANY EXCAVATION.

WHITE COPY Environmental Health YELLOW COPY (Final) Owner / Applicant PINK COPY (Initial) Owner / Applicant