IREDELL COUNTY HEALTH DEPARTMENT

STATESVILLE 704-878-5305 MOORESVILLE 704-664-5281

IMPROVEMENT PERMIT / AUTHORIZATION TO CONSTRUCT / OPERATION PERMIT / EXISTING SYSTEM INSPECTION

PERMIT# 075628 PIN# 4626 85 33 16

OWNER OR CONTRACTOR ROBERT J GADA PHONE: Business Home DATE 9/3/98

ADDRESS 146 RIDGEBROOK DR

LOCATION BRAWLEY SCHOOL - TR MCKENDREE - TR CARRIE - TR RIDGEBROOK - AT END

SUBDIVISION BLOOMINGDALE SHORE BLOCK / SECTION LOT 5 LOT AREA 1.04 AC SITE CLASS PS DESIGN FLOW 480 L.T.A.R. .35

Septic Tank: EXISTING Gallons; STB Date

Pump Tank: Gallons; PT Date

Pump Make: Model Serial No.

Nitrification Field: No Fields 1 Square Feet 255 Linear Feet 85

No Lines 1 Trench Width 36" Max Trench Bottom Depth 36" Gravel Depth 12"

☑ New System ☐ Repair System Type: I (II) III, IV, V, VI

System Description: GRAVITY CONVENTIONAL

Repair System Description: PUMP CONVENTIONAL

Maintenance Agreement Required: ☐ Yes ☑ No

☑ House/Mod. Home ☐ Mobile Home ☐ Business ☐ Other

No. Bedrooms 4 No. Bathrooms 4 No. Employees


☐ Slab ☑ Crawl Space ☐ Basement w/plumbing ☐ Basement wo/plumbing

Water Supply: ☑ Individual ☐ Public ☐ Community

Comments:/Conditions: EXISTING SYSTEM = 350' of Line @ 4 LINES

Comments:/Conditions: Lines installed short to stay out of field area at end of line

INITIAL SITE SKETCH

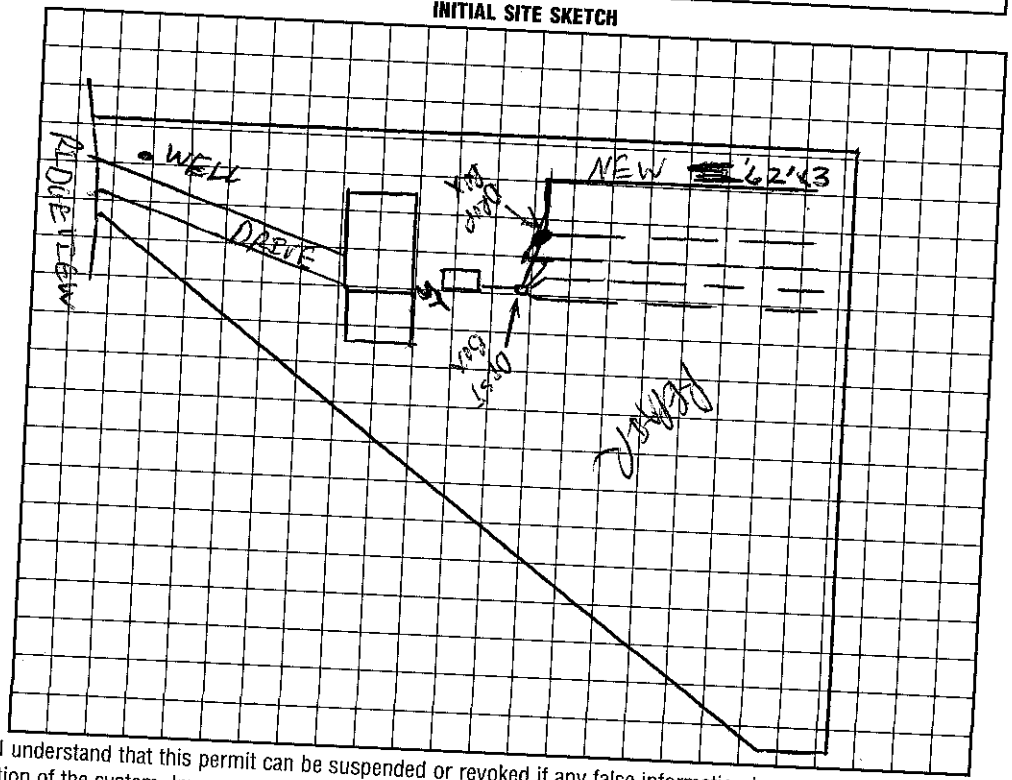

AS BUILT SKETCH

Flow diverter used in place of drop box to avoid box being above ground - Nov 5

I understand that this permit can be suspended or revoked if any false information is supplied toward securing the permit/any unauthorized changes are made to the site/any unauthorized changes are made in the installation of the system. Improvement Permit with plat valid without expiration. Improvement Permit with site plan valid for sixty months. Authorization to Construct is valid for a period equal to that of Improvement Permit – not to exceed sixty months.

Signed: Robert J Gada

Improvement Permit by: C. Mitchell RS date 9/4/98

Authorization to Construct by: C. Mitchell RS date 9/3/98

Installed by: Tim Simmons

Operation Permit by: Wesley Sparks R.S. date 9/9/98

Existing System Inspection by: date

HEALTH DEPT. COPY: WHITE INSPECTION COPY (FINAL): GREEN OWNER COPY (FINAL): YELLOW INSPECTION COPY (INITIAL): PINK OWNER COPY (INITIAL): GOLD