IREDELL COUNTY HEALTH DEPARTMENT

STATESVILLE 704-878-5305 MOORESVILLE 704-664-5281

IMPROVEMENT PERMIT / CERTIFICATE OF COMPLETION / OPERATION PERMIT / EXISTING SYSTEM INSPECTION

PROPERTY DESCRIPTION NO. 19655 DATE Dec 22, '94

OWNER OR CONTRACTOR Ray Van Eury TAX MAP NO. 2F10 B5

ADDRESS 55 Small Ave, Concord PHONE: Business Home 782-6534

LOCATION 1100 TR 1115 (mckendree) TR Carrie Ln. TR Ridgeview At end Watershed: ☑ Yes ☐ No WSIV

SUBDIVISION Brookridge Shores BLOCK / SECTION PhS4 LOT 5 LOT AREA 1.04ac SITE CLASS B

Septic Tank: 1000 Gallons; STB 225 RST Date 10-11-94 DESIGN FLOW 360 gpd L.T.A.R. 0.55

Pump Tank: Gallons; PT Date

Pump Make: Model Serial No.

Nitrification Field: No Fields 1 Square Feet 1050 Linear Feet 350

No Lines 4 Trench Width 36" Max Trench Bottom Depth 24" Gravel Depth 12"

☑ New System ☐ Repair System Type: I, II, III, IV, V, VI

System Description: gravity conventional

Repair System Description: grav/pumped conventional

Maintenance Agreement Required: ☐ Yes ☑ No

☐ Slab ☑ Crawl Space ☐ Basement w/plumbing ☐ Basement wo/plumbing

☑ House/Mod. Home No. Bedrooms 3

☐ Mobile Home No. Bathrooms 2

☐ Business No. Employees

☐ Other


Water Supply: ☑ Individual ☐ Community ☐ Public

Comments: Install trenches at 24" trench bottom depth. Any deeper than this will result in average of total system footage to 400'. Drop Boxes may be used in lieu of a single D-box w/spreading valves


Comments:

1" = 100'

INITIAL SITE SKETCH

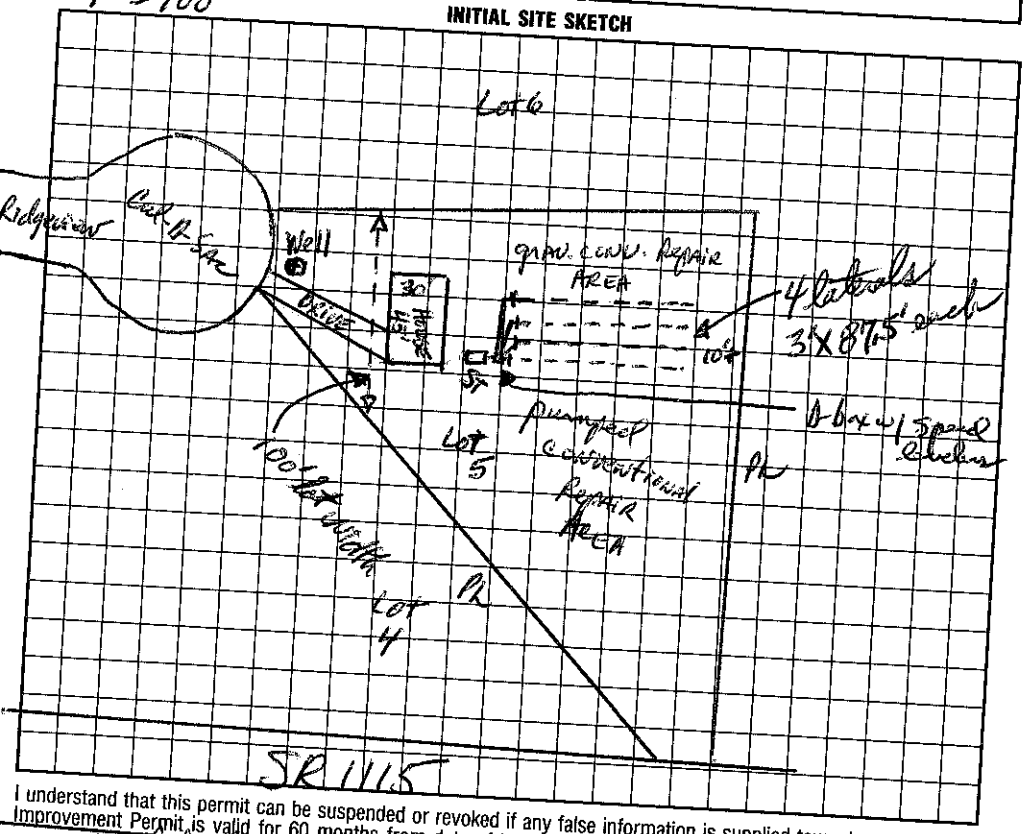

AS BUILT SKETCH

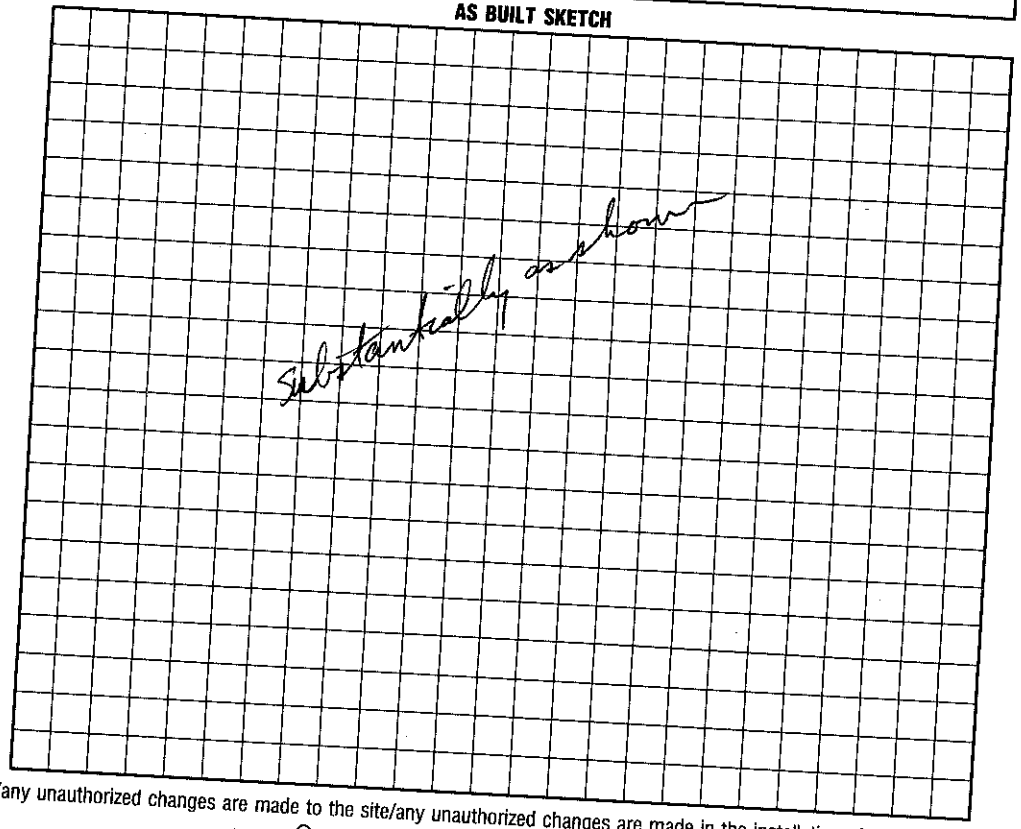

I understand that this permit can be suspended or revoked if any false information is supplied toward securing the permit/any unauthorized changes are made to the site/any unauthorized changes are made in the installation of the system. Improvement Permit is valid for 60 months from date of issuance.

Signed: X Michael Lambert Sanitarian Reg

Improvement Permit by: [signature] IRS date 12/22/94

Existing System Inspection by: date

Installed by: owner

Certificate of Completion by: [signature] date 2-14-95

Operation Permit by: date

HEALTH DEPT. COPY: WHITE INSPECTION COPY (FINAL): GREEN OWNER COPY (FINAL): YELLOW INSPECTION COPY (INITIAL): PINK OWNER COPY (INITIAL): GOLD