IREDELL COUNTY HEALTH DEPARTMENT

PIN# 4626-85-4511

STATESVILLE 704-878-5305 MOORESVILLE 704-664-5281

IMPROVEMENT PERMIT / CERTIFICATE OF COMPLETION / OPERATION PERMIT / EXISTING SYSTEM INSPECTION

PROPERTY DESCRIPTION NO. _____ DATE 4-26-95 TAX MAP NO. _____ Watershed: ☐ Yes ☐ No

OWNER OR CONTRACTOR Bob Harm PHONE: Business _____ Home 892-3119

ADDRESS 114 Blue Sky Ct Mooresville

LOCATION 1100 TR Mckentrie Rd TR Brookridge Lane 1st Home left

SUBDIVISION Brookridge BLOCK / SECTION I LOT 6 LOT AREA _____ SITE CLASS PS DESIGN FLOW 360 L.T.A.R. .35

Septic Tank: _____ Gallons; STB _____ Date _____

Pump Tank: _____ Gallons; PT _____ Date _____

Pump Make: _____ Model _____ Serial No. _____

Nitrification Field: No Fields 2 Square Feet 280 Linear Feet 140

No Lines 3 Trench Width 24" Max Trench Bottom Depth 42" Gravel Depth N/A

☐ New System ☑ Repair System Type: I, II, III, IV, V, VI

System Description: _____

Repair System Description: County Panels

Maintenance Agreement Required: ☐ Yes ☑ No

☑ House/Mod. Home No. Bedrooms 3

☐ Mobile Home No. Bathrooms 2

☐ Business No. Employees _____

☐ Other _____


☐ Slab ☑ Crawl Space ☐ Basement w/plumbing ☐ Basement wo/plumbing

Water Supply: ☑ Individual ☐ Community ☐ Public

Comments: In new distribution box use 3" pipe with speed levelers Then Reduce 3" to 1½" To Panels Recommend Converting old box To this System also.

Comments: Installed as shown. Upper laterals deep, shallow - somewhat at ends.

INITIAL SITE SKETCH

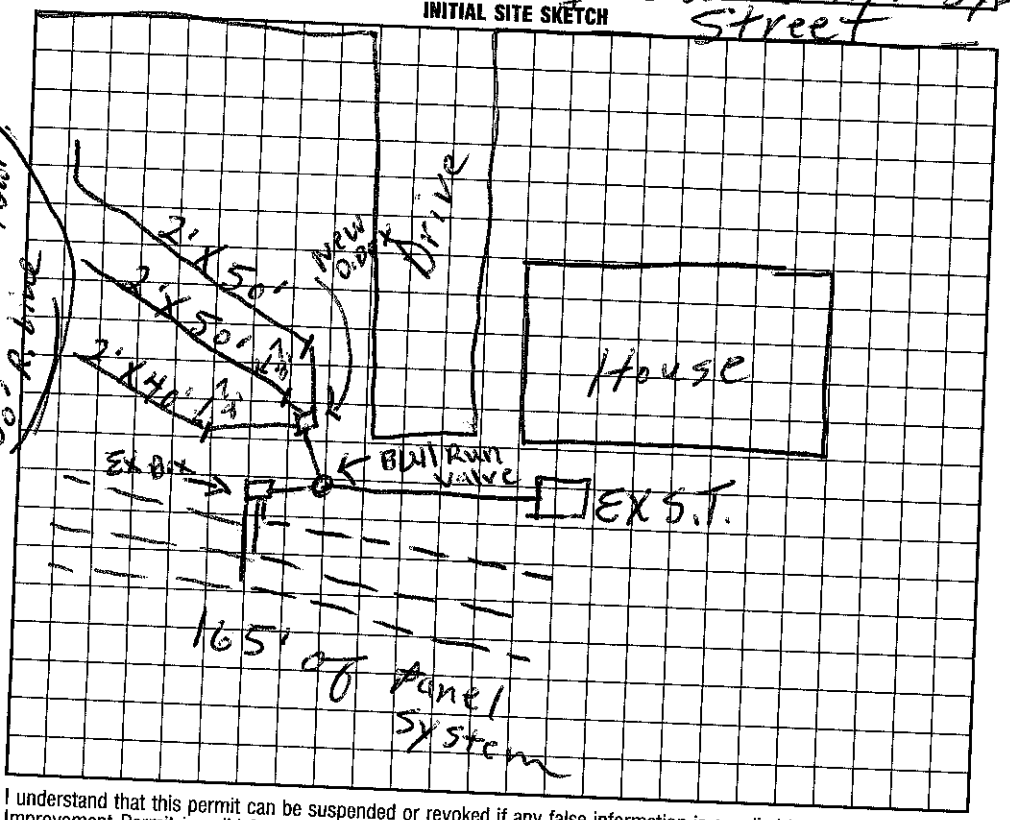

AS BUILT SKETCH

I understand that this permit can be suspended or revoked if any false information is supplied toward securing the permit/any unauthorized changes are made to the site/any unauthorized changes are made in the installation of the system. Improvement Permit is valid for 60 months from date of issuance.

Signed: X Robert L Harm

Improvement Permit by: J. C. Moore date 4-26-95

Existing System Inspection by: _____ date _____

Installed by: Richard Abernathy

Certificate of Completion by: _____ date _____

Operation Permit by: _____ date 6-1-95

HEALTH DEPT. COPY: WHITE INSPECTION COPY (FINAL): GREEN OWNER COPY (FINAL): YELLOW INSPECTION COPY (INITIAL): PINK OWNER COPY (INITIAL): GOLD