IREDELL COUNTY HEALTH DEPARTMENT

STATESVILLE 704-878-5305 MOORESVILLE 704-664-5281

IMPROVEMENT PERMIT / AUTHORIZATION TO CONSTRUCT / OPERATION PERMIT / EXISTING SYSTEM INSPECTION

PERMIT# 072195 PIN# 4626 85 6022

OWNER OR CONTRACTOR RON HORNADAY

ADDRESS 134 MCKENDREE RD - MOORESVILLE NC 28115 PHONE: Business _____ Home 664-6972

DATE 3/16/98

LOCATION BRAWLEY SCHOOL RD - TR MCKENDREE - ON RT.

SUBDIVISION _____ BLOCK / SECTION — LOT — LOT AREA _____ SITE CLASS. AS DESIGN FLOW 360 L.T.A.R. —

Septic Tank: _____ Gallons; STB _____ Date _____

Pump Tank: _____ Gallons; PT LNG Date _____

Pump Make: EXT Model _____ Serial No. _____

Nitrification Field: No Fields ___ Square Feet _____ Linear Feet _____

No Lines _____ Trench Width _____ Max Trench Bottom Depth _____ Gravel Depth _____

☑ New System ☐ Repair System Type: I II III, IV, V, VI

System Description: CONVENTIONAL

Repair System Description: SAME

Maintenance Agreement Required: ☐ Yes ☐ No

☑ House/Mod. Home No. Bedrooms 3

☑ Mobile Home No. Bathrooms ___

☐ Business No. Employees ___

☐ Other _____


☐ Slab ☐ Crawl Space ☐ Basement w/plumbing ☐ Basement wo/plumbing

Water Supply:
☑ Individual
☐ Public
☐ Community

Comments:/Conditions:

Comments:/Conditions:

INITIAL SITE SKETCH

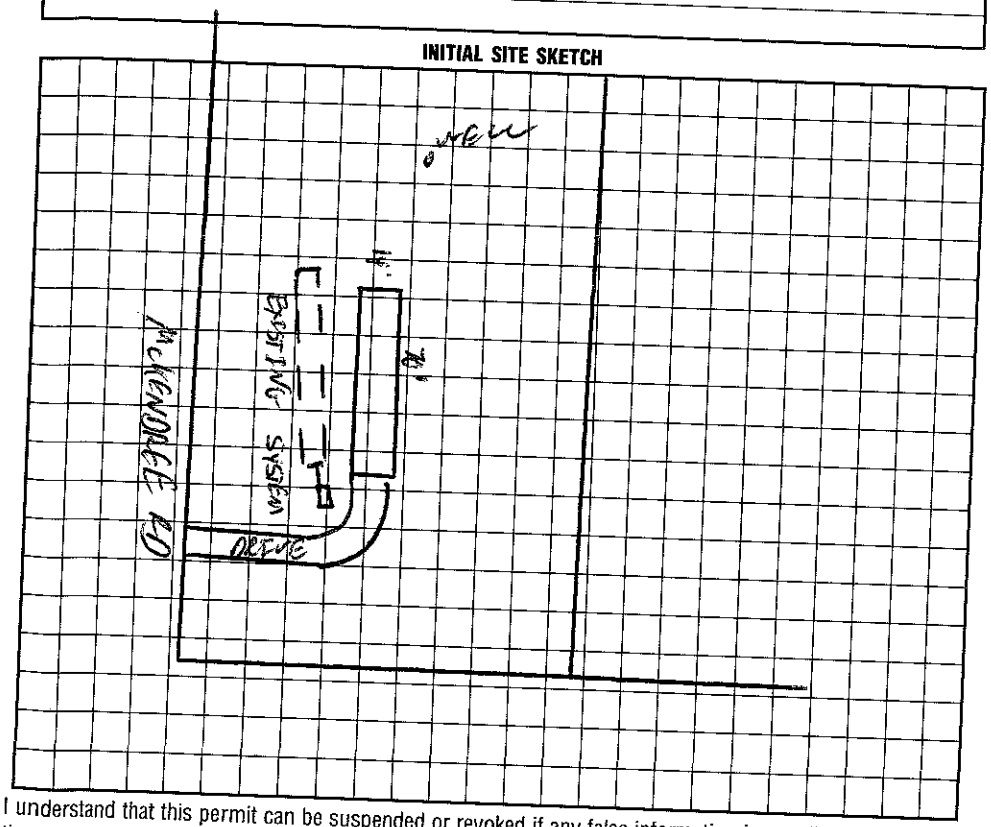

AS BUILT SKETCH

I understand that this permit can be suspended or revoked if any false information is supplied toward securing the permit/any unauthorized changes are made to the site/any unauthorized changes are made in the installation of the system. Improvement Permit with plat valid without expiration. Improvement Permit with site plan valid for sixty months. Authorization to Construct is valid for a period equal to that of Improvement Permit – not to exceed sixty months.

Signed: Paul Sprinkle date 3-17-98

Improvement Permit by: _____ date _____

Authorization to Construct by: C. W. Ramsey date 3/16/98

Installed by: _____

Operation Permit by: _____ date _____

Existing System Inspection by: C. W. Ramsey date 3/16/98

HEALTH DEPT. COPY: WHITE INSPECTION COPY (FINAL): GREEN OWNER COPY (FINAL): YELLOW INSPECTION COPY (INITIAL): PINK OWNER COPY (INITIAL): GOLD