IREDELL COUNTY HEALTH DEPARTMENT

STATESVILLE 704-878-5305 MOORESVILLE 704-664-5281

IMPROVEMENT PERMIT / CERTIFICATE OF COMPLETION / OPERATION PERMIT / EXISTING SYSTEM INSPECTION

PROPERTY DESCRIPTION NO. 18443 DATE MARCH 10, 195 TAX MAP NO. ~~2FHA1~~ 4626-85-6744 Watershed: ☐ Yes ☐ No

OWNER OR CONTRACTOR Kevin D. Combs PHONE: Business _____ Home _____

ADDRESS 9327 Mt Holly Huntersville Rd. Huntersville

LOCATION Brawley School Road TR Poplar Grove 1st lot ON left

SUBDIVISION Poplar Grove BLOCK / SECTION _____ LOT 1 LOT AREA 20,000 ft²+ SITE CLASS. PS on 1956 DESIGN FLOW 360 gpd L.T.A.R. .3

Septic Tank: 1000 Gallons; STB 794 Date 6/26/95

Pump Tank: 1000 Gallons; PT 209 Date 8/1/95

Pump Make: _____ Model _____ Serial No. _____

Nitrification Field: No Fields 1 Square Feet _____ Linear Feet 200

No Lines 2-3 Trench Width 24" Max Trench Bottom Depth 28"

☑ New System ☐ Repair System Type: I, II, III, IV, V, VI

System Description: LPPPBPS

Repair System Description: Same

Maintenance Agreement Required: ☑ Yes ☐ No

☑ House/Mod. Home No. Bedrooms 3

☐ Mobile Home No. Bathrooms 2

☐ Business No. Employees ____

☐ Other _____

Gravel Depth N/A ☐ Slab ☐ Crawl Space ☑ Basement w/plumbing ☐ Basement wo/plumbing

Water Supply: ☑ Individual ☐ Community ☐ Public

Comments:


WELL Area

Comments:

5.5 Drawdown.

1"=40'

INITIAL SITE SKETCH

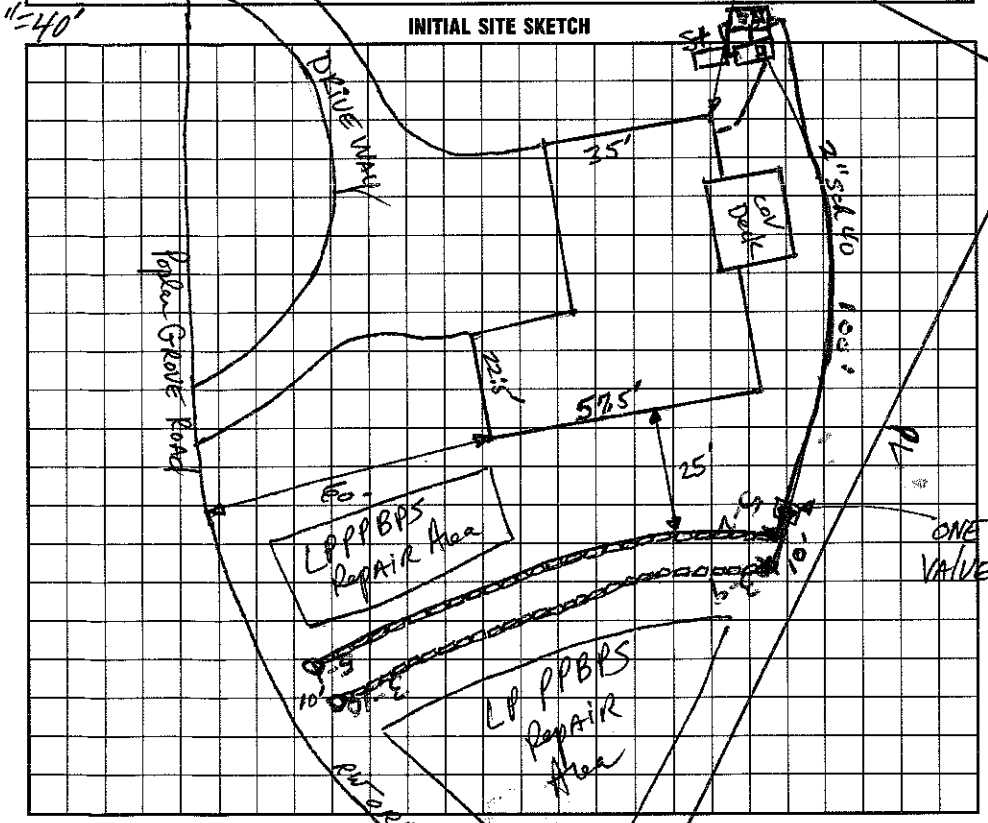

AS BUILT SKETCH

I understand that this permit can be suspended or revoked if any false information is supplied toward securing the permit/any unauthorized changes are made to the site/any unauthorized changes are made in the installation of the system. Improvement Permit is valid for 60 months from date of issuance.

Signed: X Kevin D. Combs

Improvement Permit by: Darrell Hinson R.S. date 3/10/95

Existing System Inspection by: _____ date _____

Installed by: Richard Abernathy

Certificate of Completion by: Wesley Sparks R.S. date 9/14/95

Operation Permit by: _____ date _____

HEALTH DEPT. COPY: WHITE INSPECTION COPY (FINAL): GREEN OWNER COPY (FINAL): YELLOW INSPECTION COPY (INITIAL): PINK OWNER COPY (INITIAL): GOLD