IREDELL COUNTY HEALTH DEPARTMENT

STATESVILLE 704-878-5305 MOORESVILLE 704-664-5281

IMPROVEMENT PERMIT / AUTHORIZATION TO CONSTRUCT / OPERATION PERMIT / EXISTING SYSTEM INSPECTION

PERMIT # 16416 3 PIN # 4626858744 DATE 12-15-2010

OWNER or APPLICANT Thomas & Patricia Garcia PHONE: Business 6318342408 Home: ~~631 654 5207~~ 704 660 6886

OWNER or APPLICANT ADDRESS 204 Peconic Ave Medford, NY

LOCATION / DIRECTIONS Brawley School Rd TR Poplar Grove TR Towing Bark on right

SUBDIVISION Poplar Grove BLOCK / SECTION LOT # 49 LOT AREA 1 DESIGN FLOW 360gpd L.T.A.R. .3

Septic Tank 1000 Gallons: STB 825 Date 1-3-14

Pump Tank 1000 Gallons: PT 302 Date 12-20-13

Pump Make ZOELLER Model BN152-B.4HP Serial #

Nitrification Field No Fields ___ No Lines 3 Linear Feet 210

Trench Width min. 24" Max. Trench Bottom Depth 36" Gravel Depth N/A

☒ New System ☐ Repair ☐ Expansion System Type I II III IV V VI

System Description: Pump-LP-Panel Bik

Repair System Description: Same

Maintenance Agreement Required ☒ YES ☐ NO

☐ GRAVITY ☒ PRESSURE

☒ Residence No. Bedrooms 3 ☐ Business No. Persons ___ ☐ Other No. Employees ___


☐ Slab ☒ Crawl Space ☐ Basement w/plumbing ☐ Basement w/o plumbing

Water Supply: ☒ Private ☐ Public ☐ Community

Comments / Conditions: Keep Septic System 10ft From PL If no drain at front of house then setback can be ~ 25ft Scale 1:50

Comments / Conditions: ** Must use inline filter in PT ** Any future pool must be 15ft from Septic System Note: Septic Drainfield Starts 24ft from SL

INITIAL SITE SKETCH

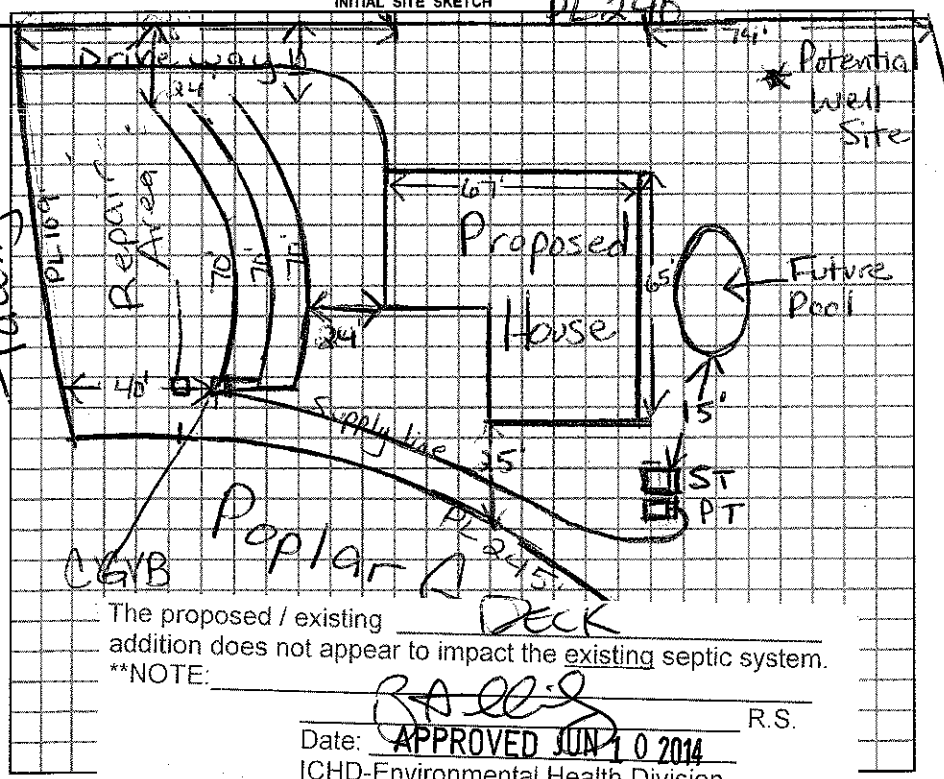

Towing Bark

The proposed / existing DECK addition does not appear to impact the existing septic system.


**NOTE:

R.S.

Date: APPROVED JUN 10 2014

ICHD-Environmental Health Division

AS BUILT SKETCH

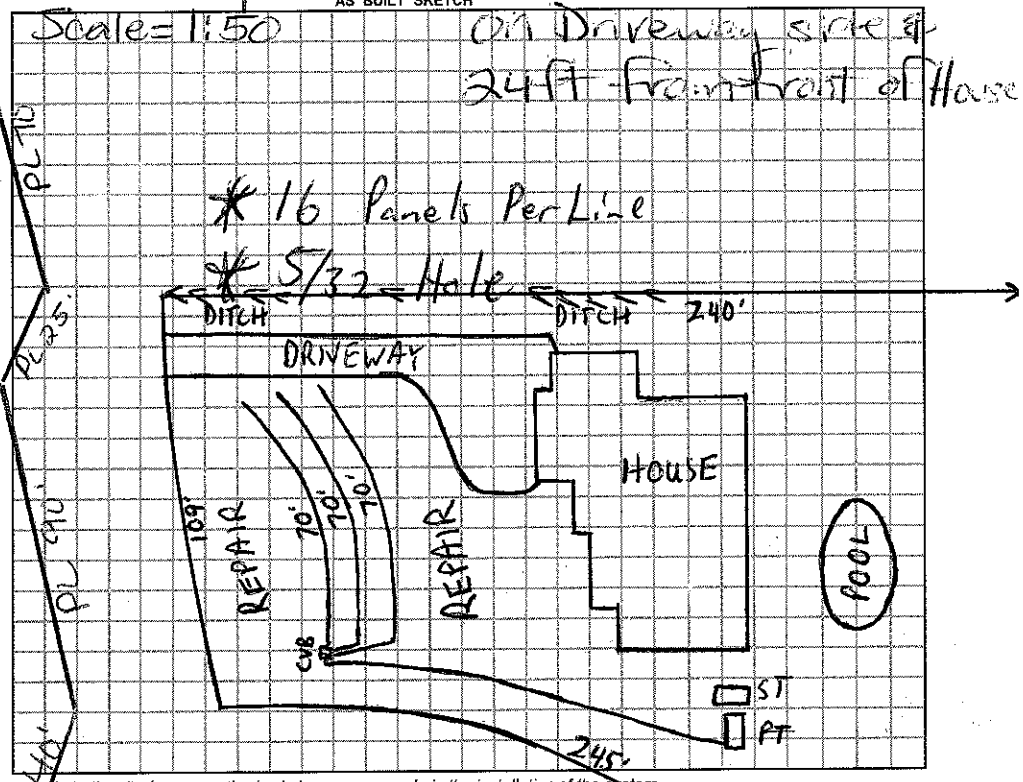

Permit can be suspended or revoked if any false information is supplied ... zed changes are made to the site / any unauthorized changes are made in the installation of the system.

☐ *IMPROVEMENT PERMIT w / plat valid without expiration.* ☐ *IMPROVEMENT PERMIT w / site plan valid for 60 mos.* ☐ *AUTHORIZATION TO CONSTRUCT valid for period equal to IMPROVEMENT PERMIT-not to exceed 60 mo.*

Owner / Applicant Signature: Debra D. Mauk Date 12/16/10

Improvement Permit by: [signature] RS Date 12/15/2010

Authorization to Construct by: [signature] RS Date 9/20/13

Installed by: ROWAN SEPTIC

Operation Permit by: [signature] Date: 2-26-14

Existing System Inspected by: Date:

YOU SHOULD CONTACT A LOCATOR SERVICE PRIOR TO ANY EXCAVATION.

WHITE COPY Environmental Health YELLOW COPY (Final) Owner / Applicant PINK COPY (Initial) Owner / Applicant

IREDELL COUNTY HEALTH DEPARTMENT

STATESVILLE 704-878-5305 MOORESVILLE 704-664-5281

IMPROVEMENT PERMIT / AUTHORIZATION TO CONSTRUCT / OPERATION PERMIT / EXISTING SYSTEM INSPECTION

PERMIT # 164163 PIN # 4626858744 DATE 12-15-2010

OWNER or APPLICANT Thomas & Patricia Garcia PHONE: Business 6318342408 Home: 6316545207

OWNER or APPLICANT ADDRESS 204 Peconic Ave Medford, NY

LOCATION / DIRECTIONS Brawley School Rd TR Poplar Grove TR Towny Back on right

SUBDIVISION Poplar Grove BLOCK / SECTION LOT # 49 LOT AREA 1 DESIGN FLOW 360gpd L.T.A.R. .3

Septic Tank 1000 Gallons: STB Date

Pump Tank 1000 Gallons: PT Date

Pump Make Model EQ/3 Serial #

Nitrification Field No Fields 1 No Lines 3 Linear Feet 210

Trench Width Min. 24" Max. Trench Bottom Depth 36" Gravel Depth N/A

☒ New System ☐ Repair ☐ Expansion System Type I II III IV V VI

System Description: Pump-LP-Panel Blk

Repair System Description: Same

Maintenance Agreement Required ☒ YES ☐ NO

☐ GRAVITY ☒ PRESSURE

☒ Residence No. Bedrooms 3

☐ Business No. Persons

☐ Other No. Employees

☐ Slab ☐ Crawl Space

☐ Basement w/plumbing ☐ Basement w/o plumbing

Water Supply: ☒ Private ☐ Public ☐ Community

Comments / Conditions: Keep Septic System 10ft from PL
If no drain at foot of house then setback can be < 25ft

Comments / Conditions: ** Must use inline filter in PT
** Any future pool must be 15ft from Septic System

INITIAL SITE SKETCH

Scale 1:50

Towny Back

Driveway

Dry Well

End Pipe

Reserve Area

Proposed House

Future Pool

Potential Well Site

Supply Line

ST

PT

Poplar Grove

CBYB

PL 240'

PL 74'

PL 10'

PL 45'

PL 40'

AS BUILT SKETCH

Scale = 1:50

Improvement Permit Only
Do Not
Issue
Building Permit

Permit can be suspended or revoked if any false information is supplied toward securing the permit / any unauthorized changes are made to the site / any unauthorized changes are made in the installation of the system.

☐ *IMPROVEMENT PERMIT w / plat valid without expiration.* ☐ *IMPROVEMENT PERMIT w / site plan valid for 60 mos.* ☐ *AUTHORIZATION TO CONSTRUCT valid for period equal to IMPROVEMENT PERMIT-not to exceed 60 mo.*

Owner / Applicant Signature: Debra D. Howell Date 12/10/10

Installed by:

Improvement Permit by: Maine Date 12/15/2010

Operation Permit by: Date:

Authorization to Construct by: Date

Existing System Inspected by: Date:

YOU SHOULD CONTACT A LOCATOR SERVICE PRIOR TO ANY EXCAVATION.

WHITE COPY Environmental Health YELLOW COPY (Final) Owner / Applicant PINK COPY (Initial) Owner / Applicant