IREDELL COUNTY HEALTH DEPARTMENT

STATESVILLE 704-878-5305 MOORESVILLE 704-664-5281

IMPROVEMENT PERMIT / AUTHORIZATION TO CONSTRUCT / OPERATION PERMIT / EXISTING SYSTEM INSPECTION

PERMIT # 16463 PIN # 4626858744 DATE 12-15-2010

OWNER or APPLICANT Thomas & Patricia Garcia PHONE: Business 6318342408 Home: ~~631 654 5207~~ 704 660 6836

OWNER or APPLICANT ADDRESS 204 Peconic Ave. Medford, NY

LOCATION / DIRECTIONS Brawley School Rd TR Poplar Grove TR Tawny Bark on right

SUBDIVISION Poplar Grove BLOCK / SECTION LOT # 49 LOT AREA 1 DESIGN FLOW 360gpd L.T.A.R. 3

Septic Tank 1000 Gallons: STB 825 Date 1-3-14 ☒ New System ☐ Repair ☐ Expansion System Type I II III IV V VI

Pump Tank 1000 Gallons: PT 302 Date 12-20-13 System Description: Pump-LP-Panel Blk

Pump Make ZOELLER Model BN152-B.4HP Serial # Repair System Description: Same

Nitrification Field No Fields ___ No Lines 3 Linear Feet 210 Maintenance Agreement Required ☒ YES ☐ NO

Trench Width Min. 24" Max. Trench Bottom Depth 36" Gravel Depth N/A ☐ GRAVITY ☒ PRESSURE


☒ Residence No. Bedrooms 3 ☐ Business No. Persons ___ ☐ Other No. Employees ___ ☐ Slab ☒ Crawl Space ☐ Basement w/plumbing ☐ Basement w/o plumbing

Water Supply: ☒ Private ☐ Public ☐ Community

Comments / Conditions: Keep Septic System 10ft From PL If no drain at front of house then setback can be ~ 25ft Scale 1:50

Comments / Conditions: ** Must use inline filter in PT ** Any future pool must be 15ft from Septic System Note: Septic Drainfield Starts 24ft from SL

INITIAL SITE SKETCH

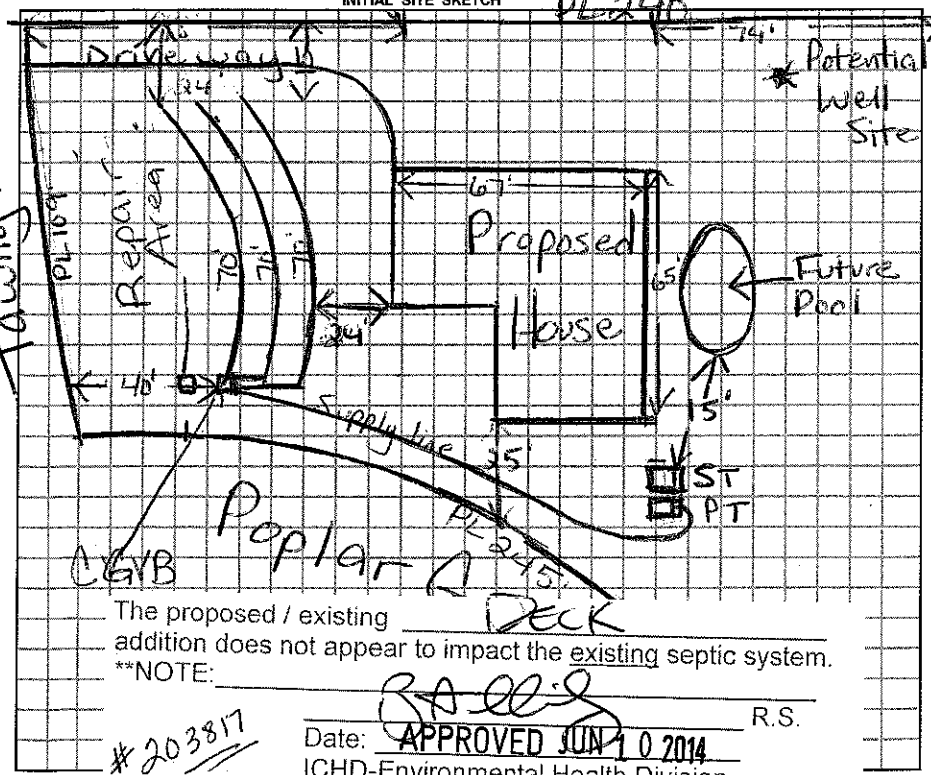

The proposed / existing DECK addition does not appear to impact the existing septic system.


**NOTE:

R.S.

#203817 Date: APPROVED JUN 10 2014

ICHD-Environmental Health Division

AS BUILT SKETCH

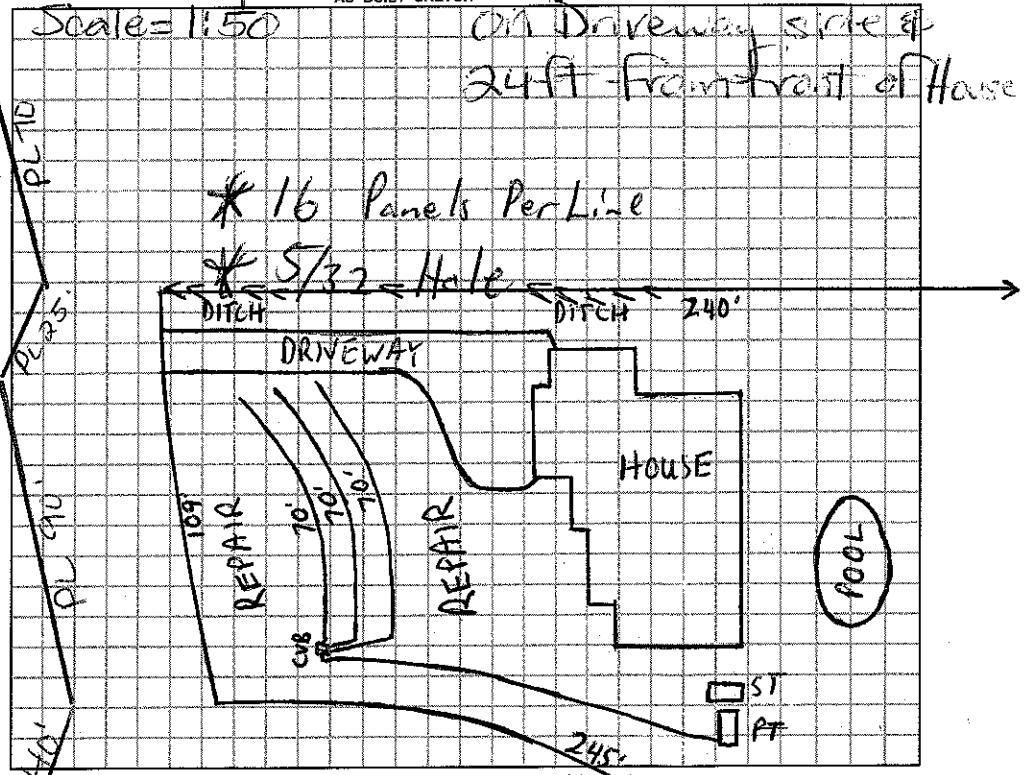

Permit can be suspended or revoked if any false information is supplied, changes are made to the site / any unauthorized changes are made in the installation of the system.

☐ IMPROVEMENT PERMIT w / plat valid without expiration. ☐ IMPROVEMENT PERMIT w / site plan valid for 60 mos. ☐ AUTHORIZATION TO CONSTRUCT valid for period equal to IMPROVEMENT PERMIT-not to exceed 60 mo.

Owner / Applicant Signature: Della D. Howell Date 12/16/10

Improvement Permit by: [signature] RS Date 12/15/2010

Authorization to Construct by: [signature] RS Date 9/20/13

Installed by: ROWAN SEPTIC

Operation Permit by: [signature] Date: 2-26-14

Existing System Inspected by: Date:

YOU SHOULD CONTACT A LOCATOR SERVICE PRIOR TO ANY EXCAVATION

WHITE COPY Environmental Health YELLOW COPY (Final) Owner / Applicant PINK COPY (Initial) Owner / Applicant