IREDELL COUNTY HEALTH DEPARTMENT

STATESVILLE 704-878-5305 MOORESVILLE 704-664-5281

IMPROVEMENT PERMIT / ~~CERTIFICATE OF COMPLETION~~ / OPERATION PERMIT / EXISTING SYSTEM INSPECTION

Suggestion to Construct

PROPERTY DESCRIPTION NO. 21823 DATE 10/24/95 TAX MAP NO. 2F 11A 48 4626859779 Watershed: [X] Yes [ ] No

OWNER OR CONTRACTOR Dave A. Kramer PHONE: Business 800-768-3669 Home 662-9299

ADDRESS 187 Lake of Pines Mooresville, NC. 28115

LOCATION Brawley School Rd. TR Poplar Grove TR Tawny Bark 2nd lot on (R) 172 Tawny Bark

SUBDIVISION Poplar Grove BLOCK / SECTION ____ LOT 48 LOT AREA .9 Ac SITE CLASS. PS DESIGN FLOW 480 L.T.A.R. .3

Septic Tank: 1000 Gallons; STB 794 Date 3/1/96

Pump Tank: 1000 Gallons; PT 29 Date 5/28/96

Pump Make: GOULD Model WE05S11H Serial No. D0962-1652

Nitrification Field: No Fields 1 Square Feet 1600 Linear Feet 266

No Lines 5 Trench Width 24" Max Trench Bottom Depth 36" Gravel Depth 6" SAND

[X] New System [ ] Repair System Type: I, II, (III), IV, V, VI

System Description: Pressure Panel

Repair System Description: None

Maintenance Agreement Required: [X] Yes [ ] No

[X] House/Mod. Home No. Bedrooms 4

[ ] Mobile Home No. Bathrooms 3

[ ] Business No. Employees ____

[ ] Other ____


[ ] Slab [ ] Crawl Space [X] Basement w/plumbing [ ] Basement wo/plumbing

Water Supply: [X] Individual [ ] Community [ ] Public


Comments:

Comments: 266 / 12 / 532 / 266 / 3192 — 52 | 3192 / 312 / 72 — 60 / 3 / 360 / 180 / 2160 — 140 = 7"

INITIAL SITE SKETCH

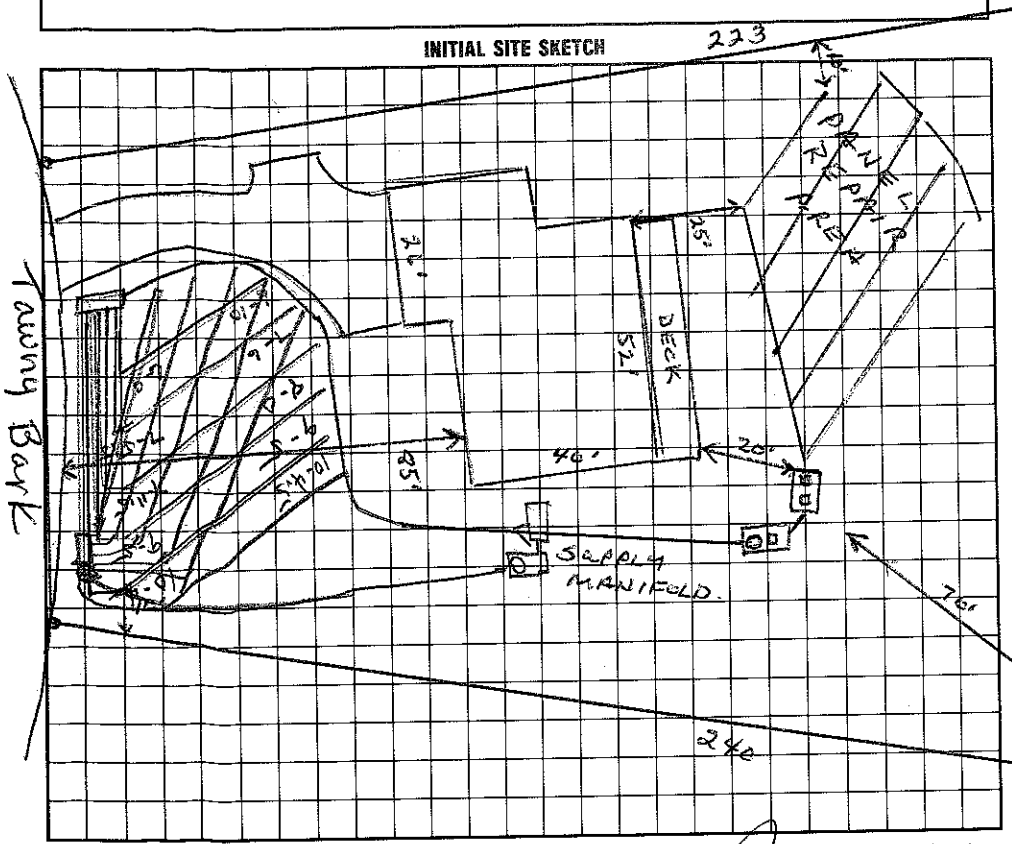

AS BUILT SKETCH

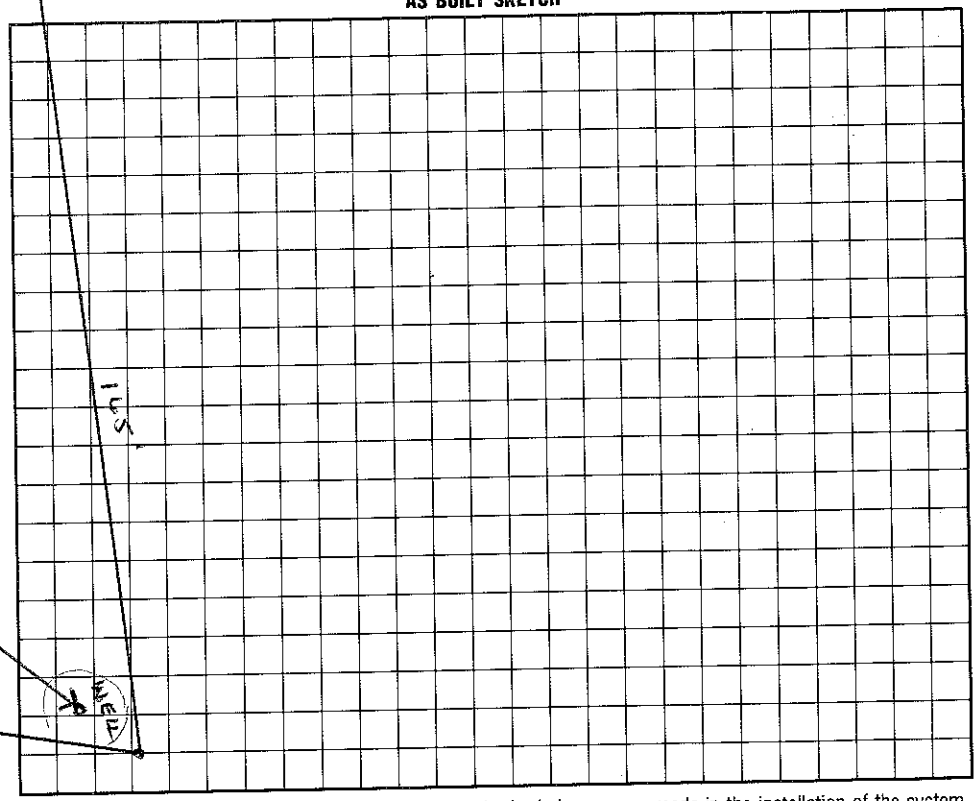

I understand that this permit can be suspended or revoked if any false information is supplied toward securing the permit/any unauthorized changes are made to the site/any unauthorized changes are made in the installation of the system.

Signed: Dave Kramer by Tony Sparks (PS Agent) Installed by: FJ Ervin

Improvement Permit by: Wesley Sparks RS. date 10/24/95 Certificate of Completion by: ____ date ____

Construct: Wesley Sparks RS. date 10/24/95 Operation Permit by: C. Brady Keene EHSI date 11/30/96

INSPECTION COPY (FINAL): GREEN OWNER COPY (FINAL): YELLOW INSPECTION COPY (INITIAL): PINK OWNER COPY (INITIAL): GOLD