IREDELL COUNTY HEALTH DEPARTMENT

Authorization to Construct — 3:00

STATESVILLE 704-878-5305 MOORESVILLE 704-664-5231

IMPROVEMENT PERMIT / ~~CERTIFICATE OF COMPLETION~~ / OPERATION PERMIT / EXISTING SYSTEM INSPECTION

PROPERTY DESCRIPTION NO. 25515 DATE 12/9/96 TAX MAP NO. 2F 11A 7 Watershed: [X] Yes [ ] No

OWNER OR CONTRACTOR Andrew Tippett PHONE: Business Home 662-8364

ADDRESS 1323 Grace Meadows Dr. Mooresville, NC. 28115 4626-86-2424

LOCATION Brawley Sch TR Poplar Grove Lane (L) to the end Turn L Head off cul-de-sac

SUBDIVISION Poplar Grove BLOCK / SECTION 1 LOT 7 LOT AREA ~.96 Ac SITE CLASS. PSD DESIGN FLOW 480 L.T.A.R. .3

Septic Tank: 1000 Gallons; STB 1612 Date

Pump Tank: Gallons; PT Date

Pump Make: Model Serial No.

Nitrification Field: No Fields 1 Square Feet 1200 * Linear Feet * 400

No Lines 3 Trench Width 36" Max Trench Bottom Depth 32" Gravel Depth SAND

[X] New System [ ] Repair System Type: I, II, (III), IV, V, VI

System Description: X CH PLASTIC

Repair System Description: SAME

Maintenance Agreement Required: [ ] Yes [X] No

[X] House/Mod. Home No. Bedrooms 4

[ ] Mobile Home No. Bathrooms 3.5

[ ] Business No. Employees

[ ] Other


[ ] Slab [ ] Crawl Space [X] Basement w/plumbing [ ] Basement wo/plumbing

Water Supply: [X] Individual [ ] Community [ ] Public


Comments:

Comments:

INITIAL SITE SKETCH

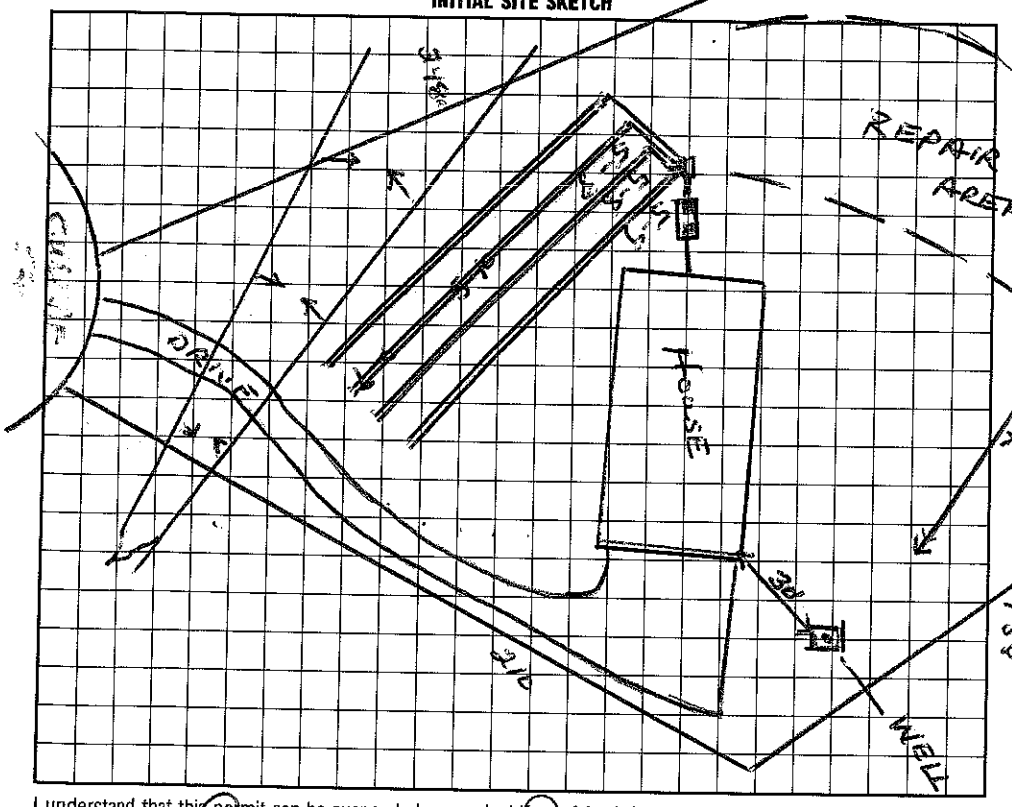

AS BUILT SKETCH

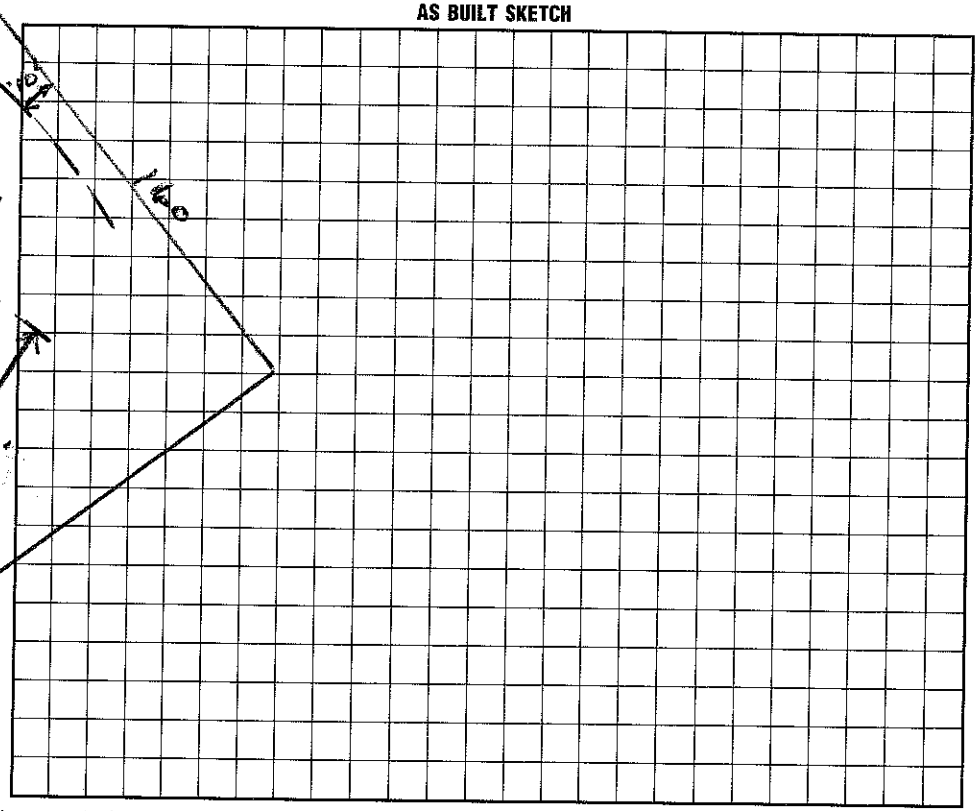

I understand that this permit can be suspended or revoked if any false information is supplied toward securing the permit/any unauthorized changes are made to the site/any unauthorized changes are made in the installation of the system.

Signed: *

Improvement Permit by: Wesley Sparks RS. date 12/9/96

Existing System Inspection by: Wesley Sparks RS. date 12/9/96

Installed by: Richard Abernethy

Certificate of Completion by: Wesley Sparks RS. date 7/9/97

Operation Permit by: Wesley Sparks RS. date 7/9/97

HEALTH DEPT. COPY: WHITE INSPECTION COPY (FINAL): GREEN OWNER COPY (FINAL): YELLOW INSPECTION COPY (INITIAL): PINK OWNER COPY (INITIAL): GOLD