IREDELL COUNTY HEALTH DEPARTMENT

STATESVILLE 704-878-5305 MOORESVILLE 704-664-5281

IMPROVEMENT PERMIT / CERTIFICATE OF COMPLETION / OPERATION PERMIT / EXISTING SYSTEM INSPECTION

PROPERTY DESCRIPTION NO. 20333 DATE 2/27/95 TAX MAP NO. 2E-11-A-5 Watershed: ☐ Yes ☒ No

OWNER OR CONTRACTOR John E. Butler PHONE: Business _____ Home 878-8334(W) 4626-86-3232

ADDRESS 1005-6 Foxcroft Ln. Statesville, NC.

LOCATION Poplar Grove on (L) before cul de sac

SUBDIVISION Poplar Grove BLOCK / SECTION _____ LOT 5 LOT AREA .65 SITE CLASS. P DESIGN FLOW ~~360~~ 480 L.T.A.R. .3

Septic Tank: 1000 Gallons; STB 994 Date 9/5/95

Pump Tank: _____ Gallons; PT _____ Date _____

Pump Make: _____ Model _____ Serial No 230 ~~535~~ A035

Nitrification Field: No Fields 1 Square Feet 1600 Linear Feet ~~1250~~

No Lines 5 Trench Width 24" Max Trench Bottom Depth 30"

☒ New System ☐ Repair System Type: I, II, ☒ III, IV, V, VI

System Description: PP135 - 16"

Repair System Description: _____

Maintenance Agreement Required: ☐ Yes ☒ No

Gravel Depth 6" SAND ☐ Slab ☒ Crawl Space ☐ Basement w/plumbing ☐ Basement wo/plumbing

☒ House/Mod. Home No. Bedrooms 3

☐ Mobile Home No. Bathrooms 2.5

☐ Business No. Employees _____


☐ Other _____

Water Supply: ☒ Individual ☐ Community ☐ Public

Comments: 16" Prefab. Panel Blocks in contain dejection shown.
4/13/95 Repair area moved to N.W. - Drainfield now becomes Repair Area. AHS

Comments:
installed as shown on Imp Permit

INITIAL SITE SKETCH

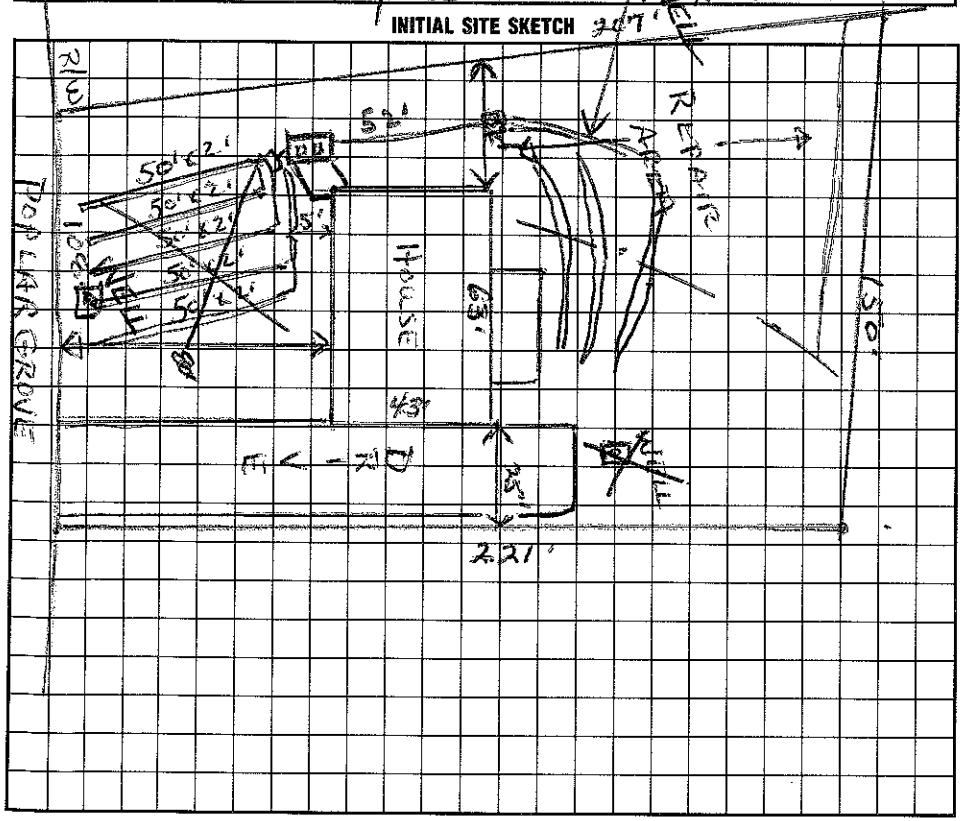

AS BUILT SKETCH

I understand that this permit can be suspended or revoked if any false information is supplied toward securing the permit/any unauthorized changes are made to the site/any unauthorized changes are made in the installation of the system. Improvement Permit is valid for 60 months from date of issuance.

Signed: John E. Butler

Improvement Permit by: Wayne Sparks RS. date 2/27/95

Existing System Inspection by: _____ date _____

Installed by: Dennis Goldberg

Certificate of Completion by: Wayne Sparks RS. date 11/16/95

Operation Permit by: Wayne Sparks RS date 11/16/95

HEALTH DEPT. COPY: WHITE INSPECTION COPY (FINAL): GREEN OWNER COPY (FINAL): YELLOW INSPECTION COPY (INITIAL): PINK OWNER COPY (INITIAL): GOLD