IREDELL COUNTY HEALTH DEPARTMENT

STATESVILLE 704-878-5305 MOORESVILLE 704-664-5281

IMPROVEMENT PERMIT / CERTIFICATE OF COMPLETION / OPERATION PERMIT / EXISTING SYSTEM INSPECTION

PROPERTY DESCRIPTION NO. 17446 DATE Dec. 10, 1993 TAX MAP NO. 2F-11-A-18 Watershed: ☑ Yes ☐ No

OWNER OR CONTRACTOR Charles Templeton PHONE: Business 663-4016 Home L.M. 4626-86-7591

ADDRESS Rt 2 Box 496 Mooresville

LOCATION 1160 TR into Poplar Grove TL ON TALL OAK DR. on left in Cul-de-Sac

SUBDIVISION Poplar Grove BLOCK / SECTION _____ LOT 18 LOT AREA .65 Ac SITE CLASS. PS on 1956 DESIGN FLOW 360 gpd L.T.A.R. .35

Septic Tank: 1000 Gallons; STB 794 Dellinger Date 3/29/94

Pump Tank: _____ Gallons; PT _____ Date _____

Pump Make: _____ Model _____ Serial No. _____

Nitrification Field: No Fields 1 Square Feet _____ Linear Feet 180

No Lines 3 Trench Width 24" Max Trench Bottom Depth 36" Gravel Depth NA

☑ New System ☐ Repair System Type: I, II, III, IV, V, VI

System Description: gravity PPBPS

Repair System Description: same

Maintenance Agreement Required: ☐ Yes ☑ No

☑ House/Mod. Home No. Bedrooms 3

☐ Mobile Home No. Bathrooms 2½

☐ Business No. Employees ____

☐ Other _____


☐ Slab ☑ Crawl Space ☐ Basement w/plumbing ☐ Basement wo/plumbing

Water Supply: ☑ Individual ☐ Community ☐ Public

Comments: Laterals to follow contours

Comments:

INITIAL SITE SKETCH

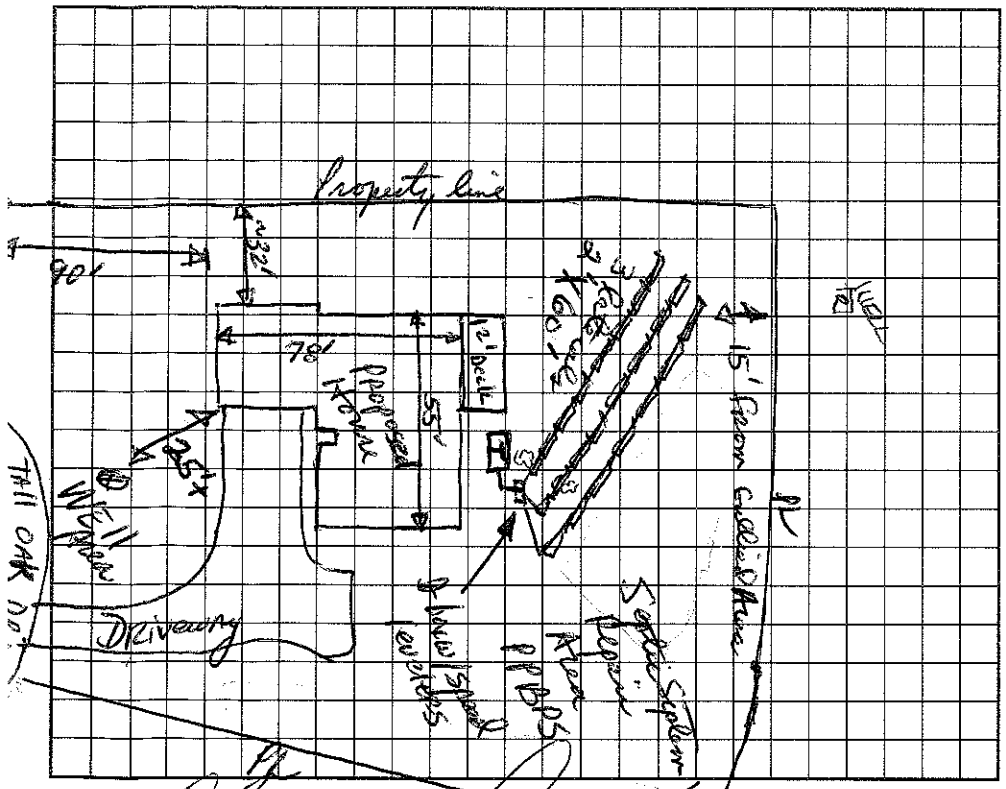

AS BUILT SKETCH

Substantially as shown on initial sketch

I understand that this permit can be suspended or revoked if any false information is supplied toward securing the permit/any unauthorized changes are made to the site/any unauthorized changes are made in the installation of the system. Improvement Permit is valid for 60 months from date of issuance.

Signed: Charles Templeton

Improvement Permit by: DAVID HINSON, RS Andrea Lemon date 12-10-93

Existing System Inspection by: _____ date _____

Installed by: J Jervon

Certificate of Completion by: _____ date _____

Operation Permit by: David R. Hinson, RS date 4/29/94

HEALTH DEPT. COPY: WHITE INSPECTION COPY (FINAL): GREEN OWNER COPY (FINAL): YELLOW INSPECTION COPY (INITIAL): PINK OWNER COPY (INITIAL): GOLD