IREDELL COUNTY HEALTH DEPARTMENT

STATESVILLE 704-878-5305 MOORESVILLE 704-664-5281

IMPROVEMENT PERMIT / AUTHORIZATION TO CONSTRUCT / OPERATION PERMIT / EXISTING SYSTEM INSPECTION

PERMIT# 076803 PIN# DATE Nov. 18, 98

OWNER OR CONTRACTOR KCI - Kvalovic Construction PHONE: Business 662-9888 Home 4626-86-9251

ADDRESS 202 Dish Circle, Mooresville

LOCATION Brawley School Rd. TR Poplar Grove TR Tawny Bark TL Tall Oak Dr. 2nd on left

SUBDIVISION Poplar Grove BLOCK / SECTION LOT 15 LOT AREA .64ac SITE CLASS. RS DESIGN FLOW 360gpd L.T.A.R. .3

Septic Tank: 1000 Gallons; STB 1017 Date 10/6/2000
Pump Tank: Gallons; PT Date
Pump Make: Model Serial No.
Nitrification Field: No Fields 1 Square Feet 600 Linear Feet 200
No Lines 4@50' Trench Width 36" Max Trench Bottom Depth 36" Gravel Depth NA

☑ New System ☐ Repair System Type: I, II, III, IV, V, VI
System Description: gravity panel block
Repair System Description: grinder pumped panel block
Maintenance Agreement Required: ☐ Yes ☑ No

☐ House/Mod. Home No. Bedrooms 3
☐ Mobile Home No. Bathrooms 3
☐ Business No. Employees
☐ Other
☐ Slab ☑ Crawl Space ☐ Basement w/plumbing ☐ Basement wo/plumbing


Water Supply: ☑ Individual ☐ Public ☐ Community

Comments:/Conditions: Drainfield area needs slight modification in order to provide good final stormwater drainage around laterals.


Comments:/Conditions:

INITIAL SITE SKETCH

1" = 50'

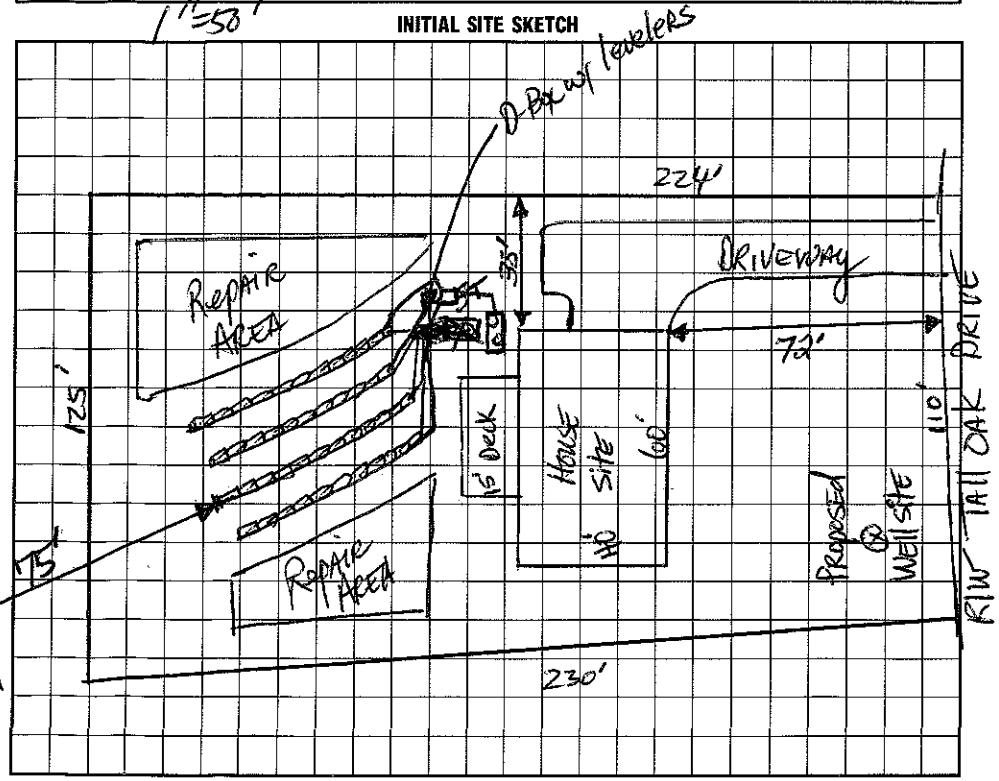

AS BUILT SKETCH

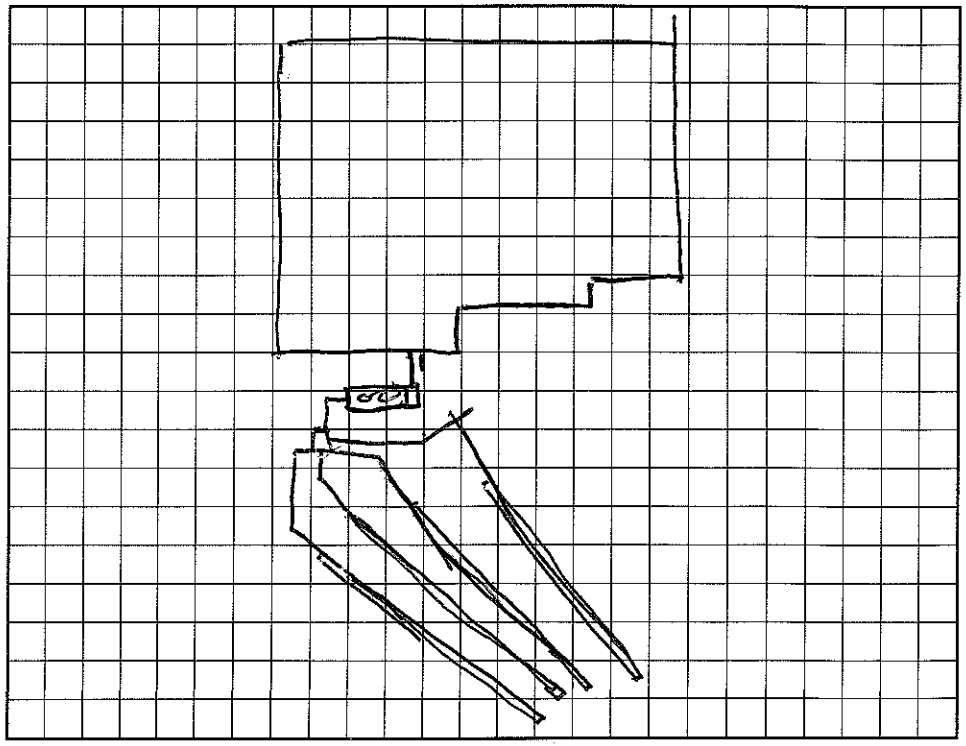

I understand that this permit can be suspended or revoked if any false information is supplied toward securing the permit/any unauthorized changes are made to the site/any unauthorized changes are made in the installation of the system. Improvement Permit with plat valid without expiration. Improvement Permit with site plan valid for sixty months. Authorization to Construct is valid for a period equal to that of Improvement Permit – not to exceed sixty months.

Signed: Tawny Kvalovic date 1/27/99

Improvement Permit by: [signature] RS date 11-18-98

Authorization to Construct by: [signature] RS date 11-18-98

Installed by: Statesville Backhoe

Operation Permit by: Wesley Sparks RS. date 4/24/01

Existing System Inspection by: date

HEALTH DEPT. COPY: WHITE INSPECTION COPY (FINAL): GREEN OWNER COPY (FINAL): YELLOW INSPECTION COPY (INITIAL): PINK OWNER COPY (INITIAL): GOLD