# IREDELL COUNTY HEALTH DEPARTMENT

STATESVILLE 704-878-5305 50.00 Paid MOORESVILLE 704-664-5281

## IMPROVEMENT PERMIT / AUTHORIZATION TO CONSTRUCT / OPERATION PERMIT / EXISTING SYSTEM INSPECTION

PERMIT# 086440 PIN# 4696 86 9311 DATE 6/9/01

OWNER OR CONTRACTOR Graham Central Land PHONE: Business Home 704-664-5342

ADDRESS 230 Hideaway Ln. Mooresville, NC. 28117

LOCATION 1100 TR Poplar Grove (R) Tawney Bank L Tall Oak, 3rd on L

SUBDIVISION Poplar Grove BLOCK / SECTION LOT 16 LOT AREA 1.0AC SITE CLASS. PS DESIGN FLOW 360 L.T.A.R. .3

Septic Tank: 1000 Gallons; STB 825 Date 10/2/4

Pump Tank: Gallons; PT Date

Pump Make: Model Serial No.

Nitrification Field: No Fields 1 Square Feet 900 ± Linear Feet 300 ±

No Lines 4 @ 75' Trench Width 3' Max Trench Bottom Depth 3' Gravel Depth SAND.

☒ New System ☐ Repair System Type: I, II, III, IV, V, VI

System Description: 25% Reduced

Repair System Description: Same

Maintenance Agreement Required: ☐ Yes ☒ No

☒ House/Mod. Home No. Bedrooms 3

☐ Mobile Home No. Bathrooms 2.5

☐ Business No. Employees

☐ Other

☐ Slab ☒ Crawl Space ☐ Basement w/plumbing ☐ Basement wo/plumbing


Water Supply: ☒ Individual ☐ Public ☐ Community

Comments:/Conditions:


Comments:/Conditions:

(1" = 40')

INITIAL SITE SKETCH

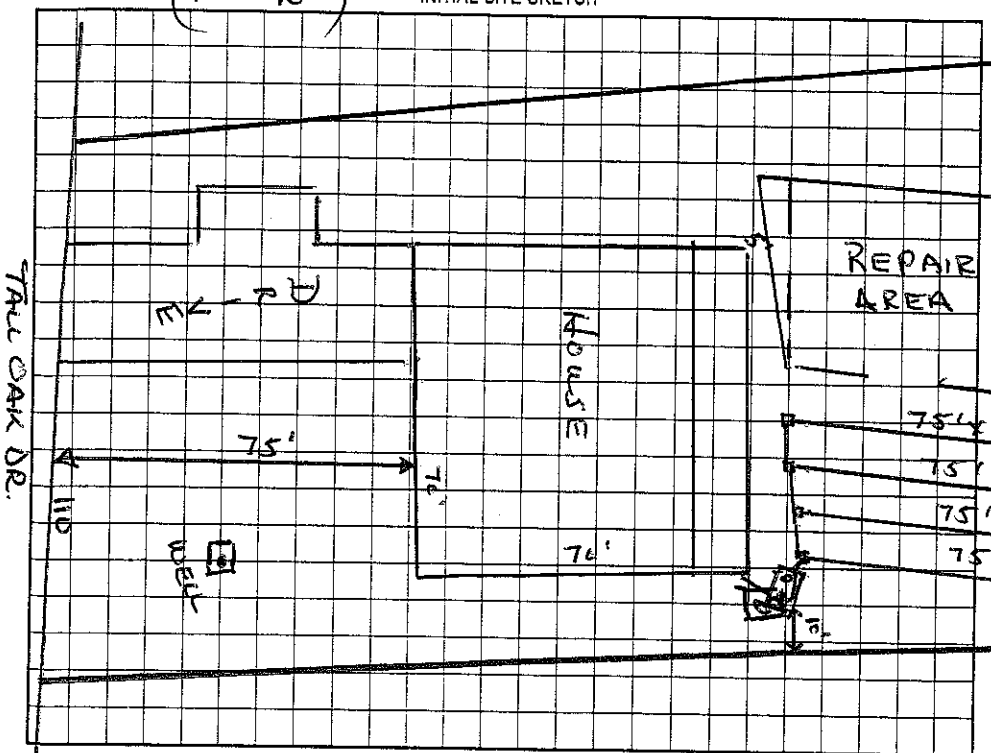


AS BUILT SKETCH

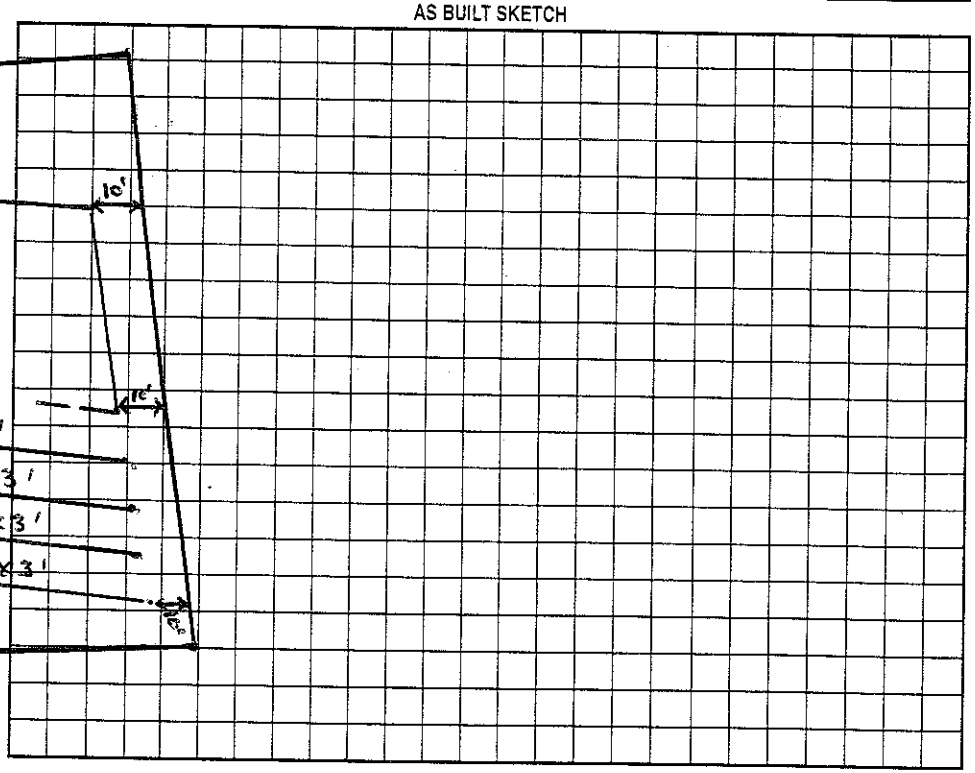


Permit can be suspended or revoked if any false information is supplied toward securing the permit/any unauthorized changes are made to the site/any unauthorized changes are made in the installation of the system. Improvement Permit with plat valid without expiration. Improvement Permit with site plan valid for sixty months. Authorization to Construct is valid for a period equal to that of Improvement Permit – not to exceed sixty months.

Signed: * Russ Graham date 2/10/01

Improvement Permit by: Wesley Sparks R.S. date 6/9/01

Authorization to Construct by: Wesley Sparks R.S. date 6/9/01

Installed by: Rowan Septic Tank

Operation Permit by: Wesley Sparks R.S. date 11/21/01

Existing System Inspection by: date

HEALTH DEPT. COPY: WHITE OWNER COPY (FINAL): YELLOW OWNER COPY (INITIAL): PINK