IREDELL COUNTY HEALTH DEPARTMENT

AUTHORIZATION TO CONSTRUCT 3:30

STATESVILLE 704-878-5305 MOORESVILLE 704-664-5281

IMPROVEMENT PERMIT / ~~CERTIFICATE OF COMPLETION~~ / OPERATION PERMIT / EXISTING SYSTEM INSPECTION

PROPERTY DESCRIPTION NO. 23389 DATE 7/24/97 TAX MAP NO. 2F-11-4-21 Watershed: ☑ Yes ☐ No

OWNER OR CONTRACTOR DALE HOLDEN PHONE: Business 4626869787 Home 391-3526

ADDRESS 1715 CRANDEN DR. CHARLOTTE NC 28216

LOCATION BRAWLEY SCHOOL RD TR POPLAR GROVE - TR TAWNY BARO DR. - TL TALL OAK DR - AT END

SUBDIVISION POPLAR GROVE BLOCK / SECTION ____ LOT 21 LOT AREA - SITE CLASS. PS DESIGN FLOW 480 L.T.A.R. .3

Septic Tank: 1000 Gallons; STB 1017 Date ~~7/24/97~~

Pump Tank: 1000 Gallons; PT 29 Date ____

Pump Make: LITTLE GIANT Model 14 EH CIM Serial No. AEA07023

Nitrification Field: No Fields 1 Square Feet 1200 Linear Feet 400

No Lines 4 Trench Width 36" Max Trench Bottom Depth 36" Gravel Depth N/A

☑ New System ☐ Repair System Type: I, II, (III), IV, V, VI

System Description: PUMP CHANGEREED

Repair System Description: PUMP/GRAV. PANEL

Maintenance Agreement Required: ☐ Yes ☑ No

☑ House/Mod. Home No. Bedrooms 4

☐ Mobile Home No. Bathrooms 3.5

☐ Business No. Employees ____

☐ Other ____


☐ Slab ☐ Crawl Space ☑ Basement w/plumbing ☐ Basement wo/plumbing

Water Supply: ☑ Individual ☐ Community ☐ Public


Comments: UPPER LINE - 9 CHAMBERS LINE 2 - 12 CHAMBERS
LINE 5 - 9 CHAMBERS LINE 1 - 12 CHAMBERS
LINE 4 - 11 CHAMBERS
LINE 3 - 11 CHAMBERS

Comments:

INITIAL SITE SKETCH

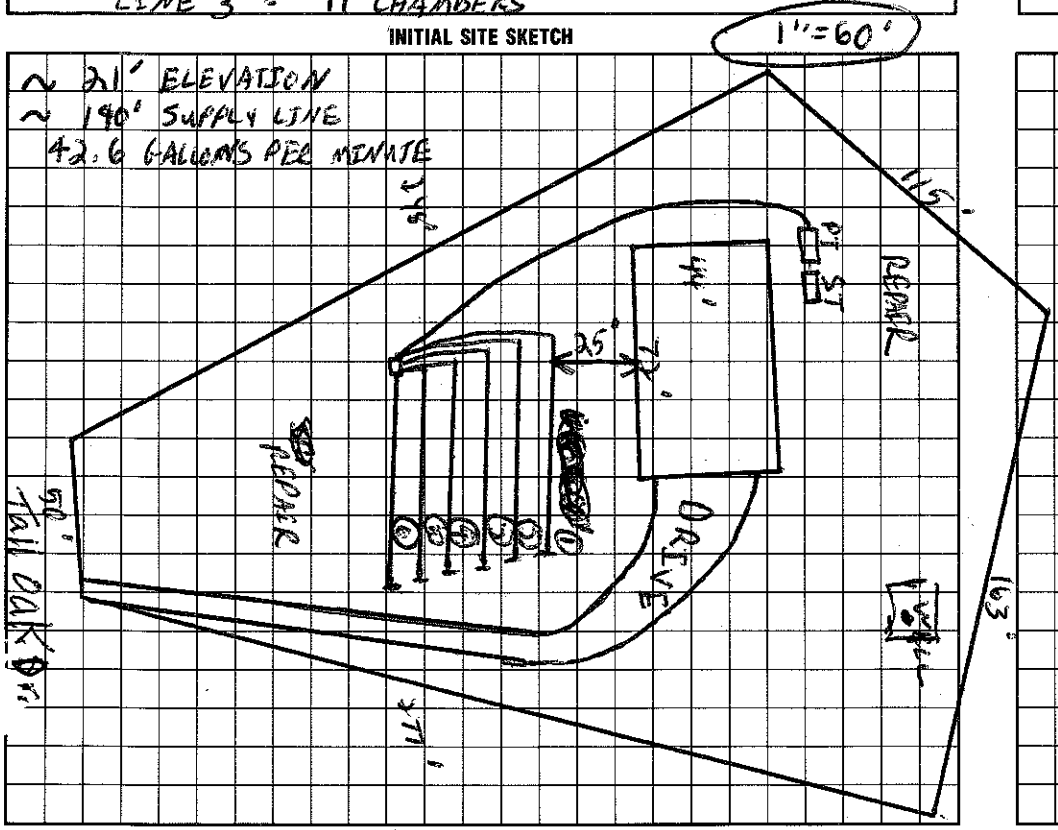

AS BUILT SKETCH

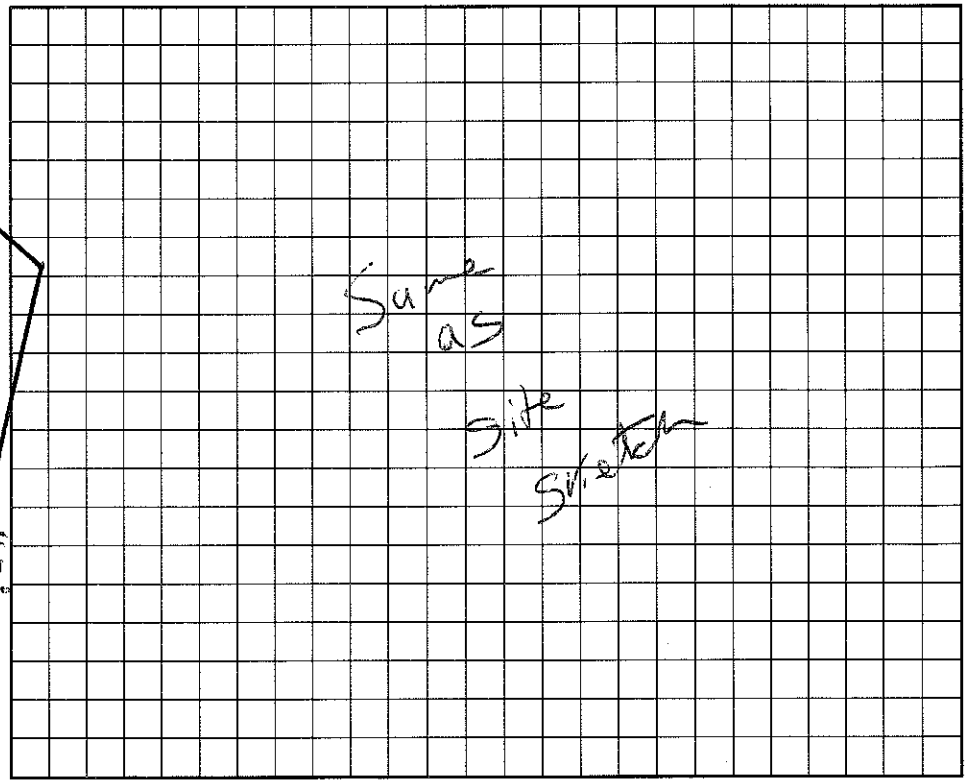

I understand that this permit can be suspended or revoked if any false information is supplied toward securing the permit/any unauthorized changes are made to the site/any unauthorized changes are made in the installation of the system. Improvement Permit is valid for 60 months from date of issuance.

Signed: Dale E. [illegible]

Improvement Permit by: [illegible] date 7/24/97

AUTHORIZATION TO CONSTRUCT Existing System Inspection by: [illegible] date 5/21/97

Installed by: Tommy Frye

Certificate of Completion by: Wesley Sparks RS. date 10/31/97

Operation Permit by: Wesley Sparks RS. date 10/31/97

HEALTH DEPT. COPY: WHITE INSPECTION COPY (FINAL): GREEN OWNER COPY (FINAL): YELLOW INSPECTION COPY (INITIAL): PINK OWNER COPY (INITIAL): GOLD