IREDELL COUNTY HEALTH DEPARTMENT

AUTHORIZATION TO CONSTRUCT

STATESVILLE 704-878-5305 MOORESVILLE 704-664-5281

4.00

IMPROVEMENT PERMIT / ~~CERTIFICATE OF COMPLETION~~ / OPERATION PERMIT / EXISTING SYSTEM INSPECTION

PROPERTY DESCRIPTION NO. 70032 DATE 12/15/97 TAX MAP NO. 4626880755

OWNER OR CONTRACTOR DENNIS HUTCHINSON PHONE: Business Watershed: ☒ Yes ☐ No

ADDRESS 129 MILLS VALLEY DR. MOORESVILLE Home 662-5610

LOCATION BRAWLEY SCHOOL - TL BEECHTREE - TR KENTS CROSSING - ON RT.

SUBDIVISION CLAT BLOCK / SECTION 8 LOT 156 LOT AREA 1.33AC SITE CLASS. PS DESIGN FLOW 360 GPD L.T.A.R. ~ .3 gpd/ft

Septic Tank: 1000 Gallons; STB 799 Date 8/12/99

Pump Tank: 1000 Gallons; PT 27 Date 11/4/98

Pump Make: Model Serial No.

Nitrification Field: No Fields 1 Square Feet 960 Linear Feet 320

No Lines 4@80' Trench Width 36" Max Trench Bottom Depth ~~28"~~ 24"

☒ New System ☐ Repair System Type: I, II, (III), IV, V, VI

System Description: PUMP CHAMBERED OR HOS

Repair System Description: SAME

Maintenance Agreement Required: ☐ Yes ☒ No

Gravel Depth

☒ House/Mod. Home ☐ Mobile Home ☐ Business ☐ Other

No. Bedrooms 3 No. Bathrooms 3 No. Employees


☐ Slab ☐ Crawl Space ☒ Basement w/plumbing ☐ Basement wo/plumbing

Water Supply: ☒ Individual ☐ Community ☐ Public


Comments:

Comments: 12/3/99 Checked drainfield, Tanks + Pressure

INITIAL SITE SKETCH

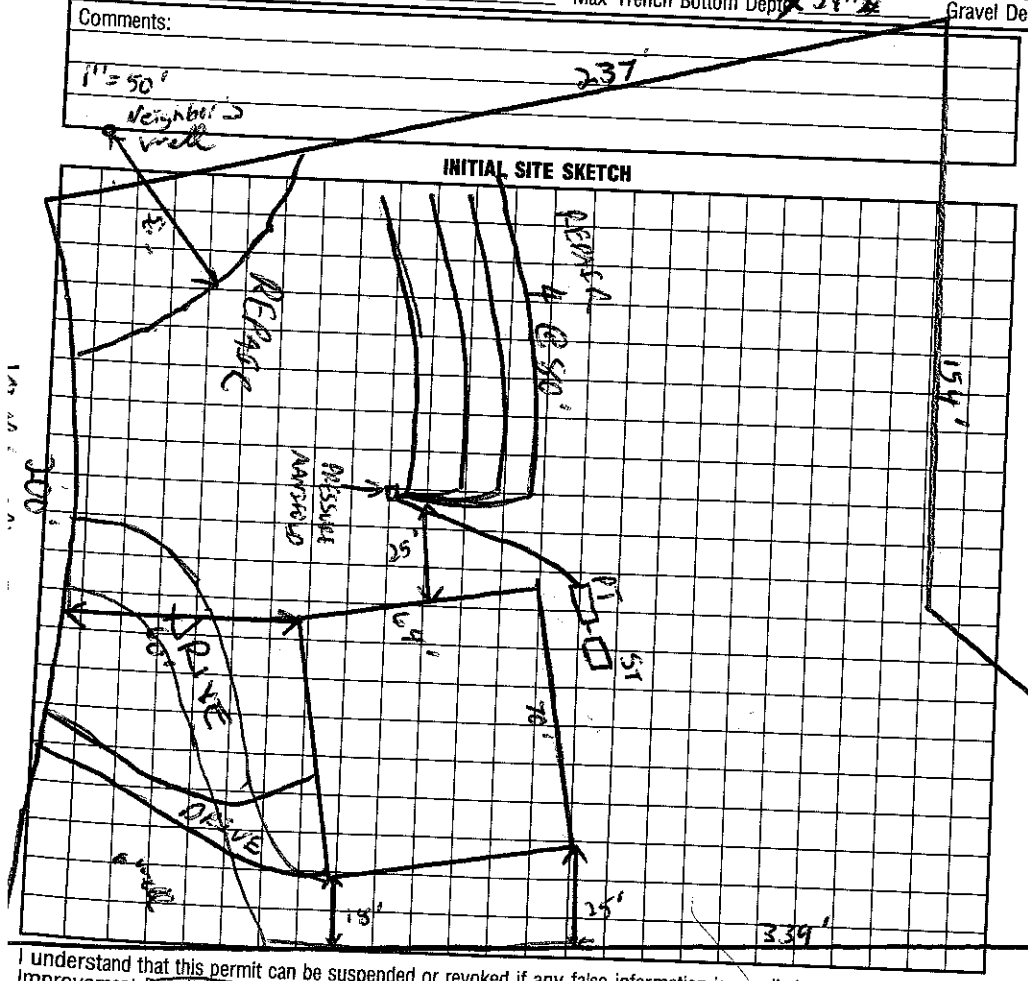

AS BUILT SKETCH

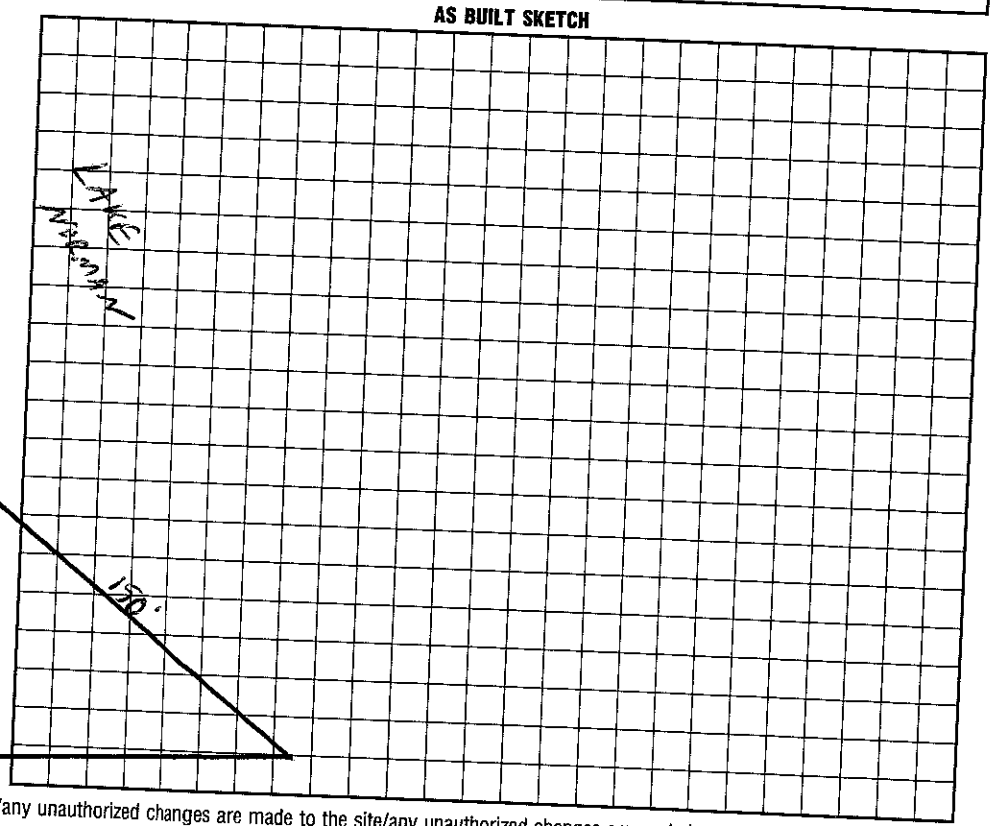

I understand that this permit can be suspended or revoked if any false information is supplied toward securing the permit/any unauthorized changes are made to the site/any unauthorized changes are made in the installation of the system. Improvement Permit is valid for 60 months from date of issuance.

Signed:

Improvement Permit by: C. M. Tatum date 12/15/97

AUTHORIZATION TO CONSTRUCT


~~Existing System Inspection by:~~ C. M. Tatum date 12/15/97

Installed by: Cecil Dugging

Certificate of Completion by: Wesley Sparks RS. date 6/21/00

Operation Permit by: date

HEALTH DEPT. COPY: WHITE INSPECTION COPY (FINAL): GREEN OWNER COPY (FINAL): YELLOW INSPECTION COPY (INITIAL): PINK OWNER COPY (INITIAL): GOLD

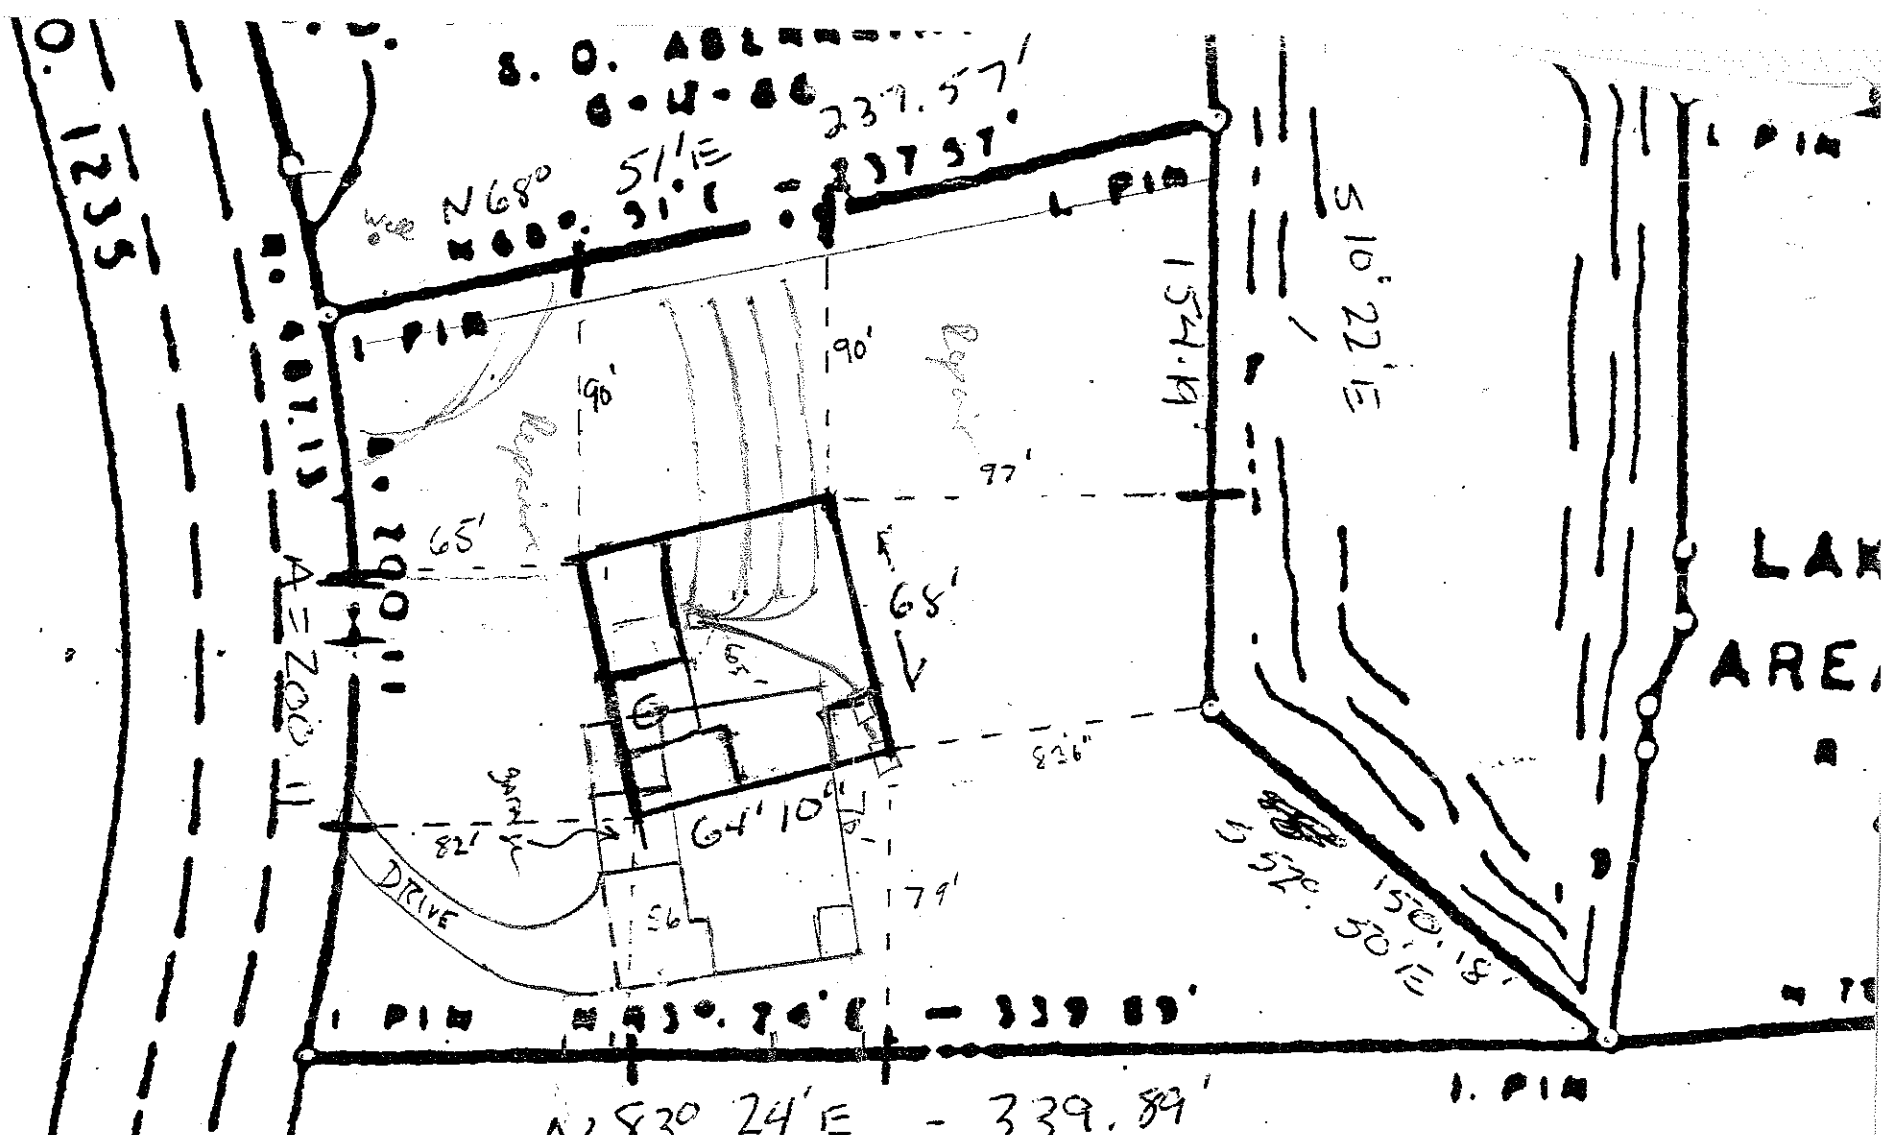

ORIGINAL Proposal