IREDELL COUNTY HEALTH DEPARTMENT

Authorization to Construct

4626 89 9904

STATESVILLE 704-878-5305 MOORESVILLE 704-664-5281

IMPROVEMENT PERMIT / ~~CERTIFICATE OF COMPLETION~~ / OPERATION PERMIT / EXISTING SYSTEM INSPECTION

PROPERTY DESCRIPTION NO. 24945 DATE 9/27/96 TAX MAP NO. 2L 4A 15 Watershed: ☒ Yes ☐ No

OWNER OR CONTRACTOR Henry Deal PHONE: Business _____ Home 664-9250 WS

ADDRESS 746 Beaton Path Rd. Mooresville, NC. 28115

LOCATION Beaton Path Rd. Brawsch TR Blume Tr Beaton Path, 4th lot from end Lane

SUBDIVISION Shadowbrook BLOCK / SECTION 9 LOT 15 LOT AREA 2+/AC SITE CLASS. PS DESIGN FLOW 360 L.T.A.R. .3

Septic Tank: 1000 Gallons; STB 1012 Date 3/28/97

Pump Tank: _____ Gallons; PT _____ Date _____

Pump Make: _____ Model _____ Serial No. _____

Nitrification Field: No Fields 1 Square Feet 1200 Linear Feet 360

No Lines 4 Trench Width 36" Max Trench Bottom Depth 36" Gravel Depth SAND

☒ New System ☐ Repair System Type: I, II, III, IV, V, VI

System Description: ACRAV-CH PLASTIC

Repair System Description: _____

Maintenance Agreement Required: ☐ Yes ☒ No

☒ House/Mod. Home ☐ Mobile Home ☐ Business ☐ Other

No. Bedrooms 3 No. Bathrooms 2.5 No. Employees _____


☐ Slab ☐ Crawl Space ☒ Basement w/plumbing ☐ Basement wo/plumbing

Water Supply: ☒ Individual ☐ Community ☐ Public


Comments:

Comments:

INITIAL SITE SKETCH

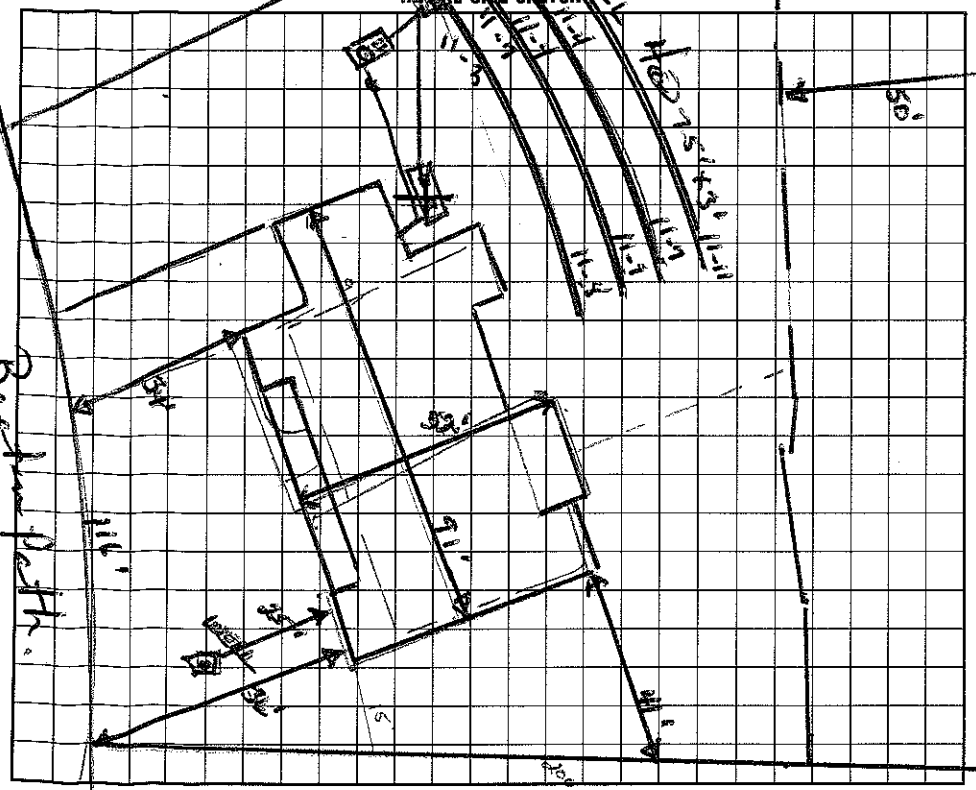

AS BUILT SKETCH

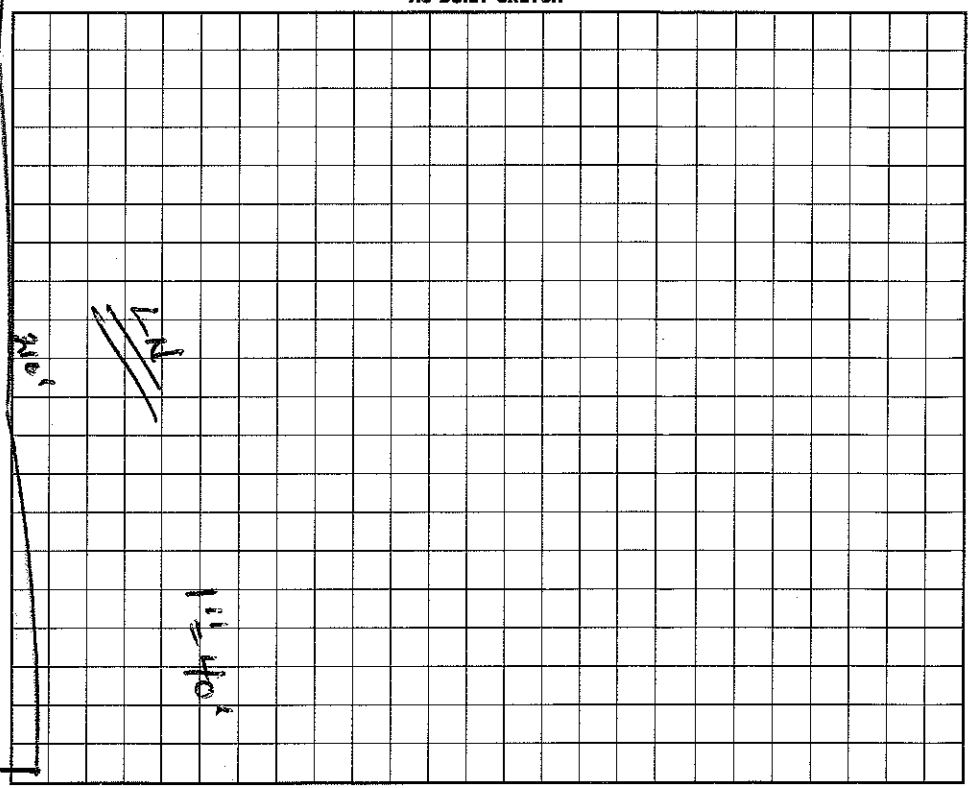

I understand that this permit can be suspended or revoked if any false information is supplied toward securing the permit/any unauthorized changes are made to the site/any unauthorized changes are made in the installation of the system.

Signed: _____ Authorization to Construct valid 60 months.

Improvement Permit by: Wesley Sparks R.S. date 9/27/96

Existing System Inspection by: Wesley Sparks R.S. date 9/29/96

Installed by: Richard Abernathy

Certificate of Completion by: Wesley Sparks R.S. date 5/30/97

Operation Permit by: Wesley Sparks R.S. date 5/30/97

HEALTH DEPT. COPY: WHITE INSPECTION COPY (FINAL): GREEN OWNER COPY (FINAL): YELLOW INSPECTION COPY (INITIAL): PINK OWNER COPY (INITIAL): GOLD